




Date: 10/27/22

TOWN OF LEXINGTON - BOARD OF PUBLIC WORKS  
WATER DIVISION

SKETCH OF SERVICE HERE

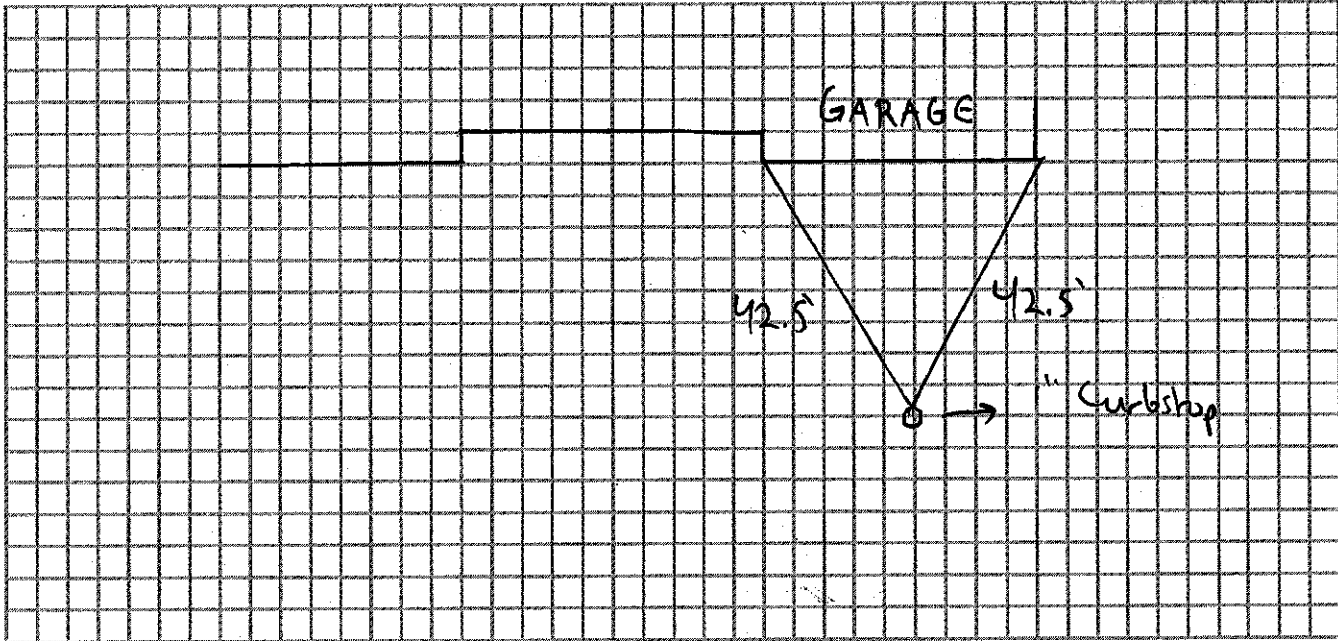

Connection made in:

Street:

Work completed:

Remarks: INSTALLED BY DIG AND DEMO LLC