


Date: 5/6/22

TOWN OF LEXINGTON - BOARD OF PUBLIC WORKS
WATER DIVISION

SKETCH OF SERVICE HERE

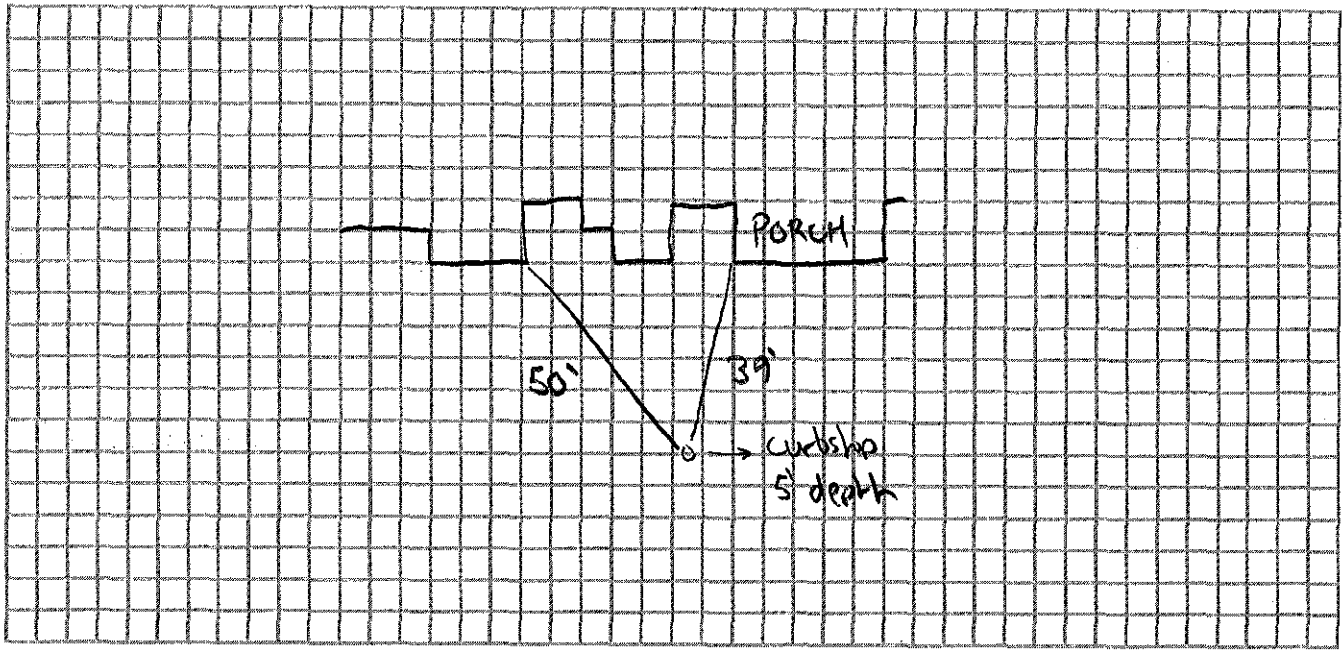

Connection made in: BLUEBERRY LN Street. Work completed:

Remarks: INSTALLED BY McLAUGHLIN