

## WATER SERVICE RECORD

Name Otis Brown

Service No.

91

Address 3 Bond Road

Location Lot 14 Sta. 1+06

~~Repair-Renewal~~ New Service

DeFlice Bros Permit #71

Comm 9-21-64


Date	Material	Amount	Total	Date	Amount
8-10-62	10' 3/4" Copper tubing @.42		4.20	8-17-64	33 3/4
	BILL WHEN CONNECTED		29 1/4		
8-19-64	74' 1" Copper tubing		33 3/4		
					NON CHARGE
				31'	3/4" Copper tubing @.42 13.02
				1	3/4" C Corp Cock 4.91
				1	3/4" C Curb Cock 6.28
				1	Box & Rod 4.90
					29.11

DATE \_\_\_\_\_

TOWN OF LEXINGTON — BOARD OF PUBLIC WORKS

WATER DIVISION

Sketch of Service Here

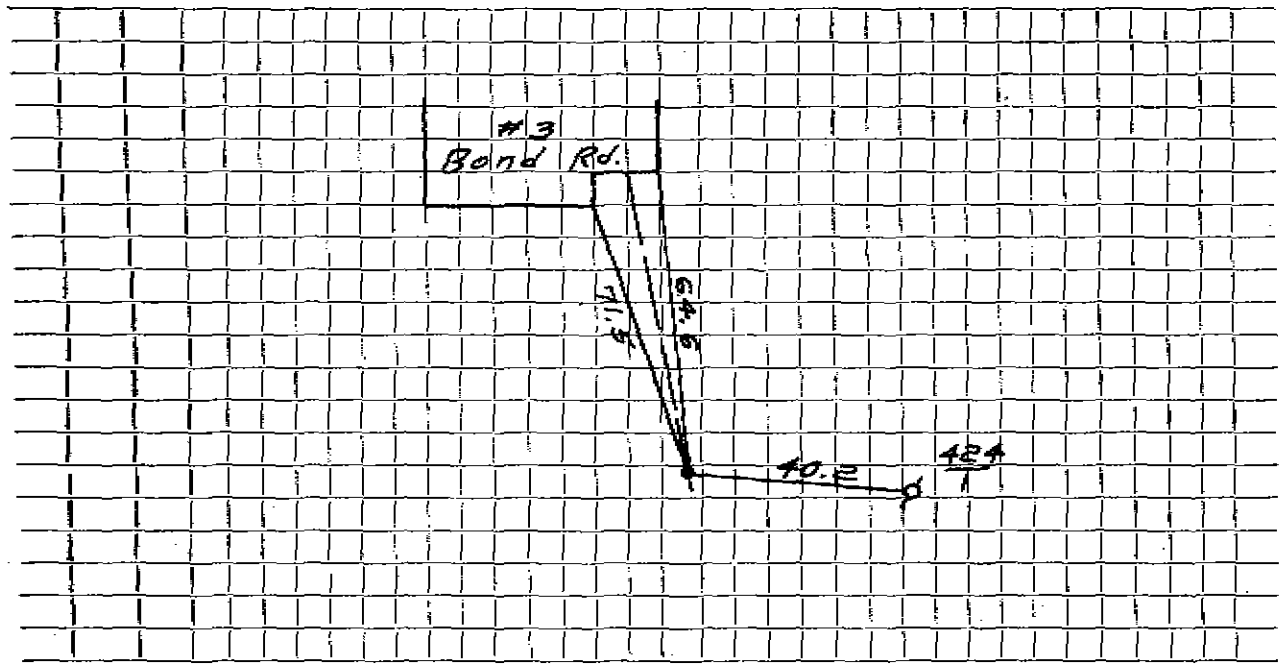

Connection made in ..... Street. Work completed .....

Remarks: .....  
.....  
.....