

# 4433

WATER SERVICE RECORD

Name Edgewood Construction, Inc.

Service No. 48

Address 7 Bond Road

Location Lot 15 Sta. 2+58

~~Water Record~~ - New Service Kirkland & Shaw Permit #381

SEP 27 1965


Date	Material	Amount	Total	Date	Amount	
8-10-62	10' 3/4" Copper tubing @.42 BILL WHEN CONNECTED		4.20 <del>41.29</del> 45.49	7-8-65	Deposit	45.49
7-8-65	44' 3/4" copper tubing				NON CHARGE	
				60'	3/4" Copper tubing @.42	25.20
				1	3/4" G Corp Cock	4.91
				1	3/4" G Curb Cock	6.28
				1	Box & Rod	4.90
						41.29

DATE \_\_\_\_\_

TOWN OF LEXINGTON — BOARD OF PUBLIC WORKS

WATER DIVISION

Sketch of Service Here

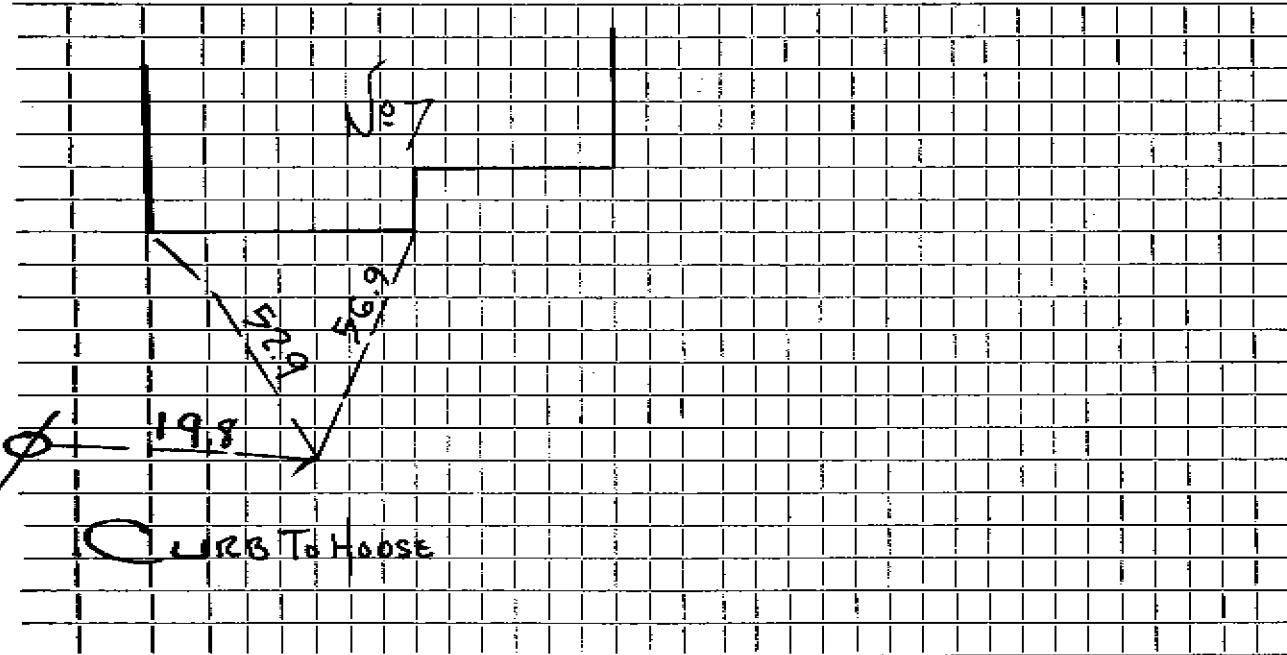

$\frac{424}{3}$

Connection made in ..... Street. Work completed .....

Remarks: .....  
.....  
.....