

WATER SERVICE RECORD

Name Gerald P. Friel

Service No. 100

Address 14 Boulder Rd.

# 6919

Location Lexington

~~Repair Work~~ - New Service


*Conn. 8-10-53*

Date	Material	Amount	Total	Date	Amount	
5/15/53	Labor	3 25		5-15-53	60 00	
7/1/53	Labor	13 34		5-13-53	6 94	
		16 59			NON CHARGE	
	10% overhead	1 66	18 25	6/23/53	Labor	4 00
	75'-3/4" Copper Tubing @.3629		27 22	7/1/53	Labor	23 46
	1-3/4" C x 1/2 I.W.H. STOP & WASTE	4 00		29'-3/4" Copper Tubing @.3629		10 52
	1-3/4" C x 3/4" C. Union(3 Parts)	1 72		1-3/4" C. Corp-cock		4 33
	2 Hr. Littlefield Shovel@7.50		15 00	1-3/4" C x 3/4" C. Curb-cock		4 67
	1 Hr. Trucking		75	1-Box & Rod		3 90
			66 94	1-1/2 offset tail piece		50
				1-1/2 straight tail piece		50
	PART OF TRENCH DUG BY OWNER			2 hr. #37 Compressor @1.75		3 50
				10 lbs Dynamite @.24		2 40
				18 Caps @.1435		2 58
				4 Hr Littlefield Shovel@7.50		30 00
				3 Hr. Trucking @.75		2 25
						92 61
				1-20-62	Frozen service	21.84
				1-1-65	FROZEN	

DATE \_\_\_\_\_

TOWN OF LEXINGTON - BOARD OF PUBLIC WORKS  
WATER DIVISION

Sketch of Service Here

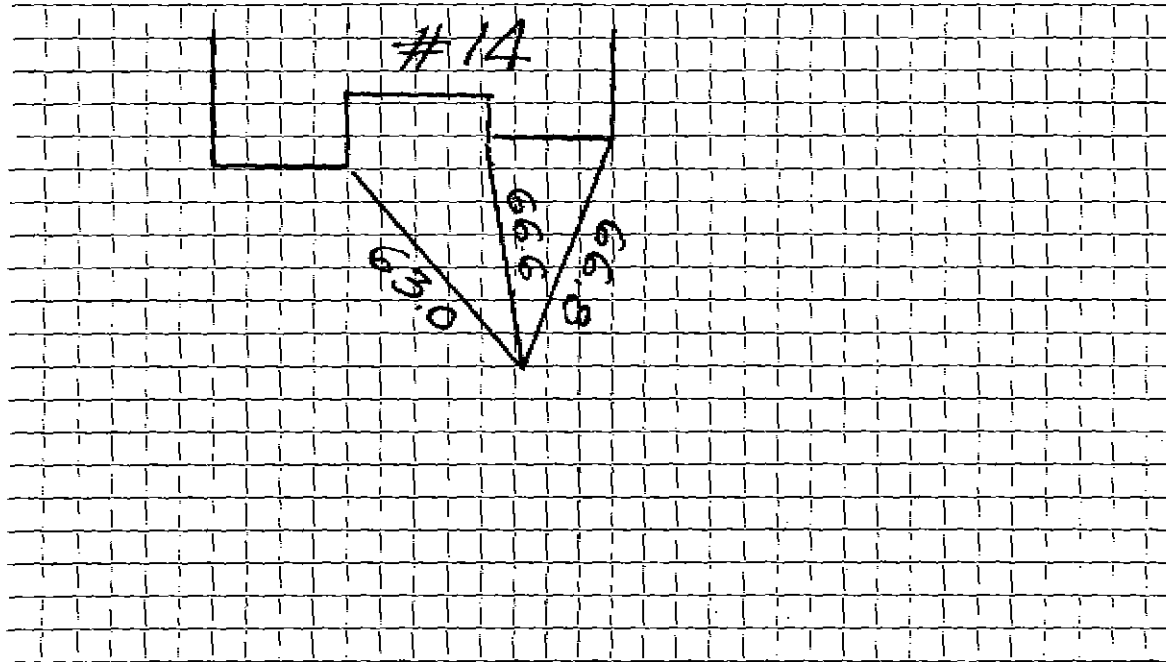

Connection made in ..... Street: ..... Work completed .....

Remarks: 8/7/86 Lower Water Service - 31' 3/4" Copper & 31' Insulation .....

.....  
.....