

Name George E. Talbot

Service No. 100
1689

Address 17 Boulder Road

Lexington, Mass.

Location 17 Boulder Road

Kind of Pipe

Size

Size of Main

~~Repair - Renewal~~ New Service

Com. 12-13-49

Location

Date	Material	Amount	Total	Date	Amount
Sept. 15, '49	Labor	7 78		Sept 14 49	45 00
Sept. 20, '49	Labor	9 60		Mar 10 50	60 76
Sept. 21, '49	Labor	20 37	37 75		105 76
	10% Overhead		3 78	Sept. 21, '49	20 00
	70' - 3/4" Copper Tubing @.24		16 80	Sept. 22, '49	27 77
	1 - 3/4"C x 1/8" I.W.H. S*W		3 29	44' - 3/4" Copper Tubing @.24	10 56
	1 - 3/4"C x 3/4"C Union (3pts)		1 39	1 - 3/4" Corp-cock	3 15
	Littlefield Shovel 4 hrs. @7.00	28 00	28 00	1 - 3/4" x 3/4" C Curb-cock	3 85
	Brox Compressor 4 hrs. @ 1.88	7 52	7 52	1 - Box & Rod	3 75
	Dynamite 9 lbs. @ .215		1 94	Littlefield Shovel 4 hrs @ 7.00	28 00
	Exploders 8 @.117		94	Brox Comp. 4 hrs. @ 1.88	7 52
	Rockwood 3 bags @ 1.20		3 60	Dynamite 5 lbs. @.215	1 08
	Labor Trucking 1 hr. @.75		75	Exploders 7 @.117	82
			105 76	Trucking 1 hr. @.75	75
	<i>Bill sent 12-2-49</i>				107 25

DATE _____

TOWN OF LEXINGTON - BOARD OF PUBLIC WORKS

WATER DIVISION

The undersigned applies for a supply of water at No..... St. and hereby agrees to comply with the rules and regulations as now, or at any future time, established by the Board of Selectmen.

Am't of Estimate \$.....

Owner


Am't Paid \$.....

Address

Builder

.....

Sketch of Service Here
Boulder Rd

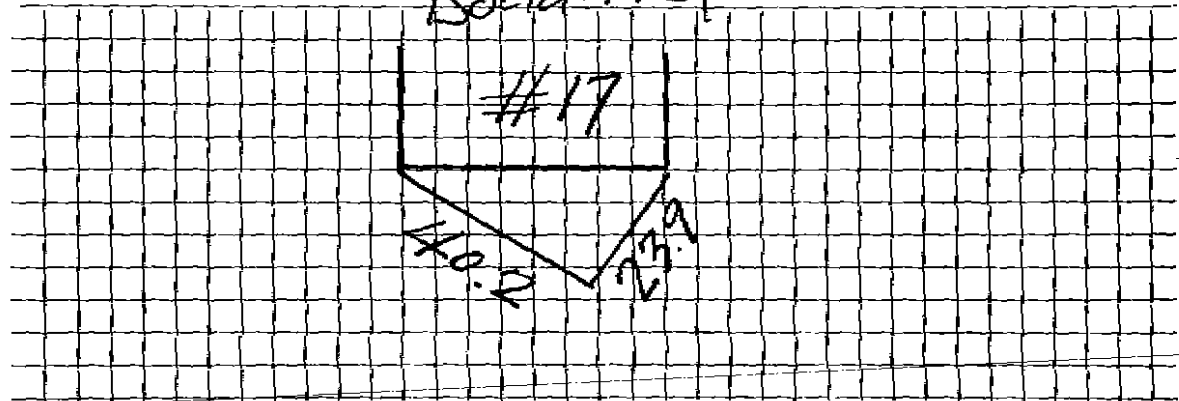

Connection made in Street.

Work completed19

Remarks: