

Name George Chick

Service No. 2341

Address 18 Boulder Road

5786

Lexington, Mass.

Location 18 Boulder Road

Kind of Pipe

Size

Size of Main

~~Repair - Renewal~~ - New Service

Cor. 12-13-49

Location

Date	Material	Amount	Total	Date	Amount
Nov. 16, '49	Labor	1 30	1 30	Oct 29 '49	60 00
	10% Overhead		13	Nov. 22 '49	62 85
	57' - 3/4" Copper Tubing @.24	13 68	13 68		47 15
	1 - 3/4" C x 1/2" I.W.H. S&W	3 29	3 29	Nov. 21, '49	68 98
	Littlefield Shovel 4 hrs. @ 7.00	28 00	28 00	Nov. 22, '49	32 43
	Trucking 1 hr. @.75		75	52' - 3/4" Copper Tubing @.24	12 48
			47 15	1 - 3/4" C Corp-cock	3 15
				1 - 3/4" C x 3/4" Curb-cock	3 85
				1 - 3/4" C x 3/4" C Union (3pts)	1 39
				1 - box & rod	3 75
	No Charge			1 - 1/2" Offset Tail Piece	37
	Dynamite 13 lbs. @.215		2 80	1 - 1/2" Straight Tail Piece	37
	Labor Exploders 10 @.117		1 17	Compressor 4 hrs. @ 1.75	7 00
	Trucking 4 hrs. @.75		3 00	Littlefield Shovel 1 1/2 hrs. @ 7.00	10 50
			272 74	Brox Shovel 13 1/3 hrs. @ 9.00	121 50
				2-14-49 Frozen Service 4.40	

DATE _____

TOWN OF LEXINGTON - BOARD OF PUBLIC WORKS

WATER DIVISION

The undersigned applies for a supply of water at No..... St. and hereby agrees to comply with the rules and regulations as now, or at any future time, established by the Board of Selectmen.

Am't of Estimate \$.....

Owner


Am't Paid \$.....

Address

Builder

.....

Sketch of Service Here
Baldwin Rd

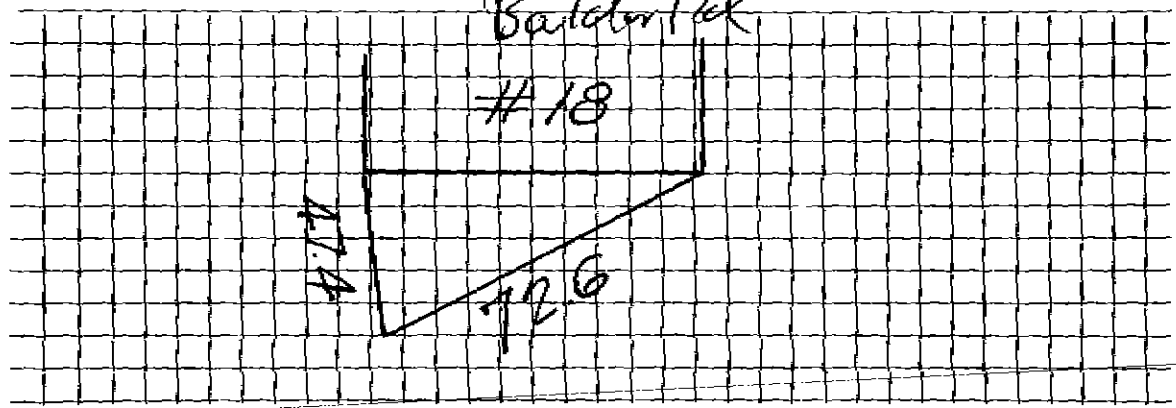

Connection made in Street.

Work completed19

Remarks: