

Name Stanley Locke

Service No. ²⁶

Address 9 Boulder Road
Lexington, Mass.

Location 9 Boulder Road

3609

Kind of Pipe

Size

Size of Main

Repair - Renewal - New Service

Location

Date	Material	Amount	Total	Date	Location	Amount
Oct. 1, 48	Labor	1 15	1 15	Sept. 26, 48	Deposited	20 00
	10% Overhead		12	Nov. 18, 48	Added	3 32
	66' - 3/4" Copper Tubing @.255	16 83			Non-Charge	23 32
	1 - 3/4" C x 3/2" I.W.H. S&W	3 15		Sept. 30, 48	Labor	1 75
	1 - 3/4" C x 3/4" C Union (3pts)	1 32		Oct. 1, 48	Labor	7 82
	Trucking 1 hr. @.75	75	23 32	9' - 3/4" Copper Tubing @.255		2 30
				1 - 3/4" C Corp-cock		3 00
				1 - 3/4" C x 3/4" C curb-cock		3 68
				1 - Box & Rod		3 55
				1 - 1/2" Straight Tail Piece		30
				1 - 1/2" Offset Tail Piece		30
				Littlefield Shovel 1 1/2 hrs. @7.00		10 50
				Trucking 1 hr. @.75		75
						33 95

trench dug by owner

30 paid 10/25/48
Labor

Hadley Press, Inc., Lexington

DATE _____

TOWN OF LEXINGTON—BOARD OF PUBLIC WORKS

WATER DIVISION

The undersigned applies for a supply of water at No. _____ St. and hereby agrees to comply with the rules and regulations as now, or at any future time, established by the Board of Selectmen.

Am't. of Estimate \$ _____


Owner _____

Am't. Paid \$ _____

Address _____

Builder _____

Sketch of Service Here

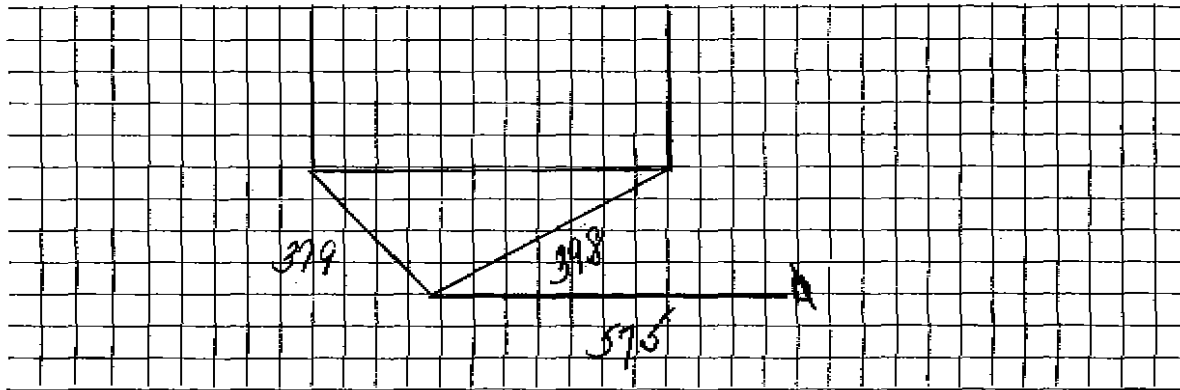

Connection made in _____ Street. Work completed _____ 19

Remarks: