

Name Isabel A. Martin  
 Address 84 Bourne St., Jamaica Plain

1471  
 Service No. 2-1941 3

Location #7 Abbott Road

Kind of Pipe Size Location  
 Repair—Renewal—New Service

| Date 1941  | Material                        | Amount | Total   | Date            | Location  | Amount |
|------------|---------------------------------|--------|---------|-----------------|-----------|--------|
| April 29   | 12 hrs. @ 60¢                   | 7 20   |         | January 3, 1941 | Deposited | 90 00  |
| Jan 4/9/41 | 10% Overhead                    | 72     | 7 92    | June 13 1941    | Returned  | 23 98  |
|            | 120' 1½" C. Tubing @ 30¢        |        | 36 00   |                 |           | 66 02  |
|            | 1 ¾" C. Corp. cock              |        | 2 25    |                 |           |        |
|            | 1 1½" C x 1½" C. Curb cock      |        | 7 41    |                 |           |        |
|            | 1 ¾" C x 1½" C Y Branch         |        | 2 25    |                 |           |        |
|            | 1 1½" C x 1½" I. Coupling       |        | 1 55    |                 |           |        |
|            | 1 1" I. x 1" I. Y W. H. S. & W. |        | 2 95    |                 |           |        |
|            | 1 1½" C x 1" I. 90° Elbow       |        | 1 04    |                 |           |        |
|            | 1 1½" C x 1½" C Union (3 parts) |        | 90      |                 |           |        |
|            | Construction charge             |        | 3 75    |                 |           |        |
|            |                                 |        | \$66 02 |                 |           |        |
|            | Labor                           |        |         |                 |           |        |

Hadley Press, Inc., Lexington

*Access Installation*

DATE \_\_\_\_\_

*10/10*

# TOWN OF LEXINGTON - BOARD OF PUBLIC WORKS WATER DIVISION

The undersigned applies for a supply of water at No. \_\_\_\_\_ St. and hereby agrees to comply with the rules and regulations as now, or at any future time, established by the Board of Selectmen.

Am't. of Estimate \$ 243.00  
*Water*  
*Access*

Owner C. C. DAVIS (OWNER)


Am't. Paid \$ \_\_\_\_\_

Address 49 PEQUOISSETT ST. BELMONT ST.

Builder J. C. MARTIN

J. C. MARTIN (BUILDER)  
84 BOWANE ST. TEL. ARNOLD 4973.

Sketch of Service Here

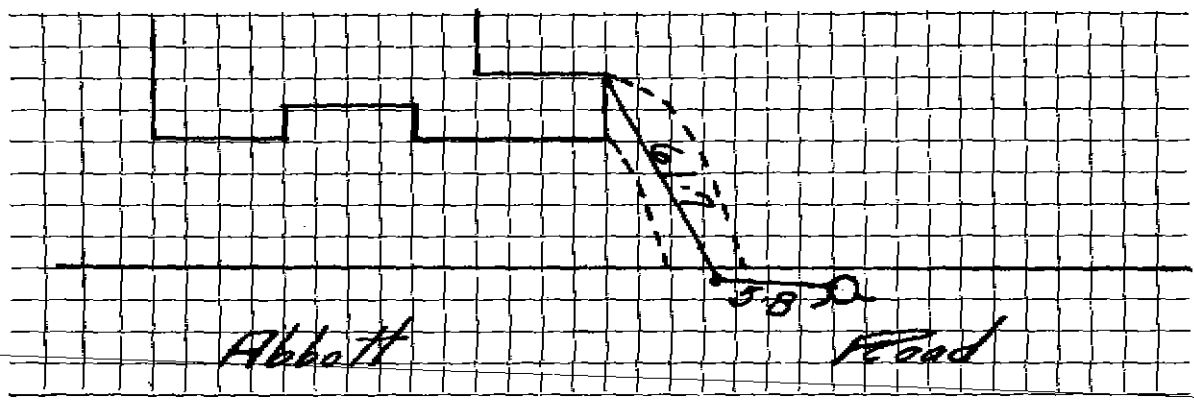

Connection made in \_\_\_\_\_ Street. Work completed \_\_\_\_\_ 19\_\_

Remarks: