




WATER DIVISION

Sketch of Service Here

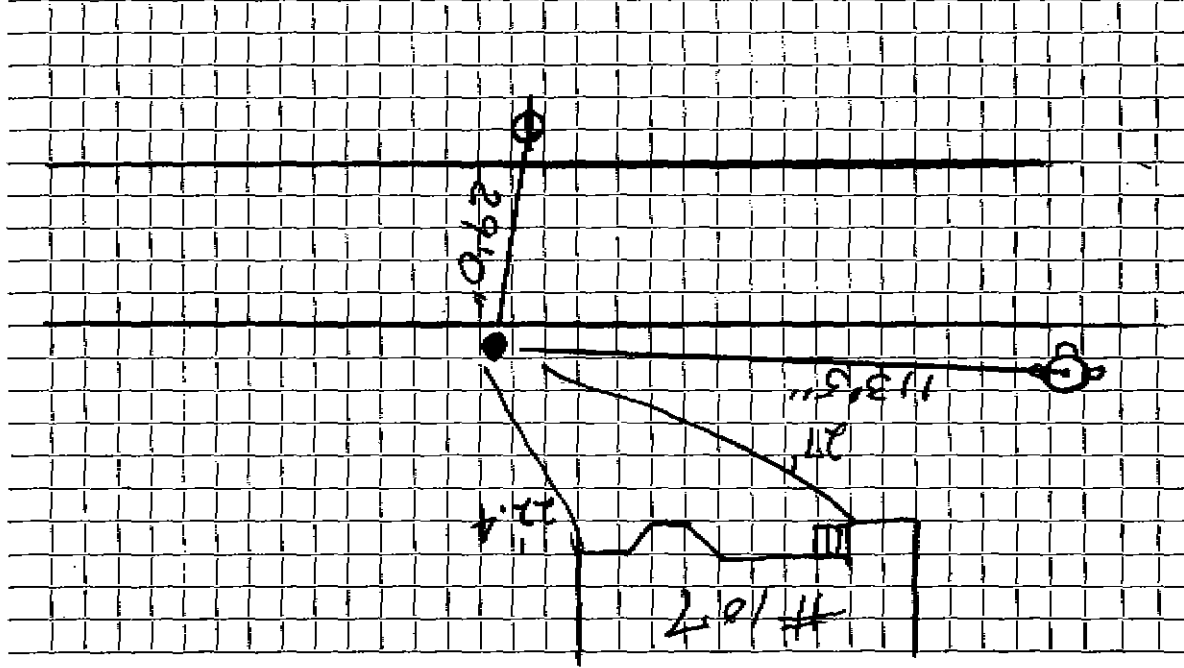

Connection made in Street, Work completed

Remarks: