

Name Carmine Massimilla

Service No. ⁶⁰

3297

Address 108 Bow Street

Location Near 108 Bow Street (Pit Meter)

Kind of Pipe

Size

Size of Main

~~Repair~~—New Service

Comm 12/31/47

Location

Date	Material	Amount	Total	Date	Location	Amount
7/15/47	Labor	16 47	16 47	7/15/47	Deposited	57 00
	10% Overhead		1 65	12/31/47	Deposited	1 04
	13' 1" Cop. Tubing @ .38		4 94			48 96
	1 1"Cx1" I.W.H. S&W		5 15		Non-Charge	
	Patching 22x3		22 00	7/14/47	Labor	16 47
	1 hr. Trucking		75	7/16/47	Labor	31 93
			48 96	27' 1" Cop. Tubing @ .38		10 26
				1 1" C. Corp. Cock		4 42
				1 1"Cx1"C. Curb-cock		5 36
				1 Box and Rod-		4 26
				2 1"Cx1" I Union (2 pts.)		
				1 1"Cx1"C. Union (3 pts.)		
	Labor			1 Pit Cover and Frame		
				2 1" Straight Tail Pieces		
				1 hr. Trucking		75

DATE _____

TOWN OF LEXINGTON - BOARD OF PUBLIC WORKS
WATER DIVISION

The undersigned applies for a supply of water at No. St. and hereby agrees to comply with the rules and regulations as now, or at any future time, established by the Board of Selectmen.

Am't of Estimate \$.....


Owner

Am't Paid \$.....

Address

Builder

Sketch of Service Here

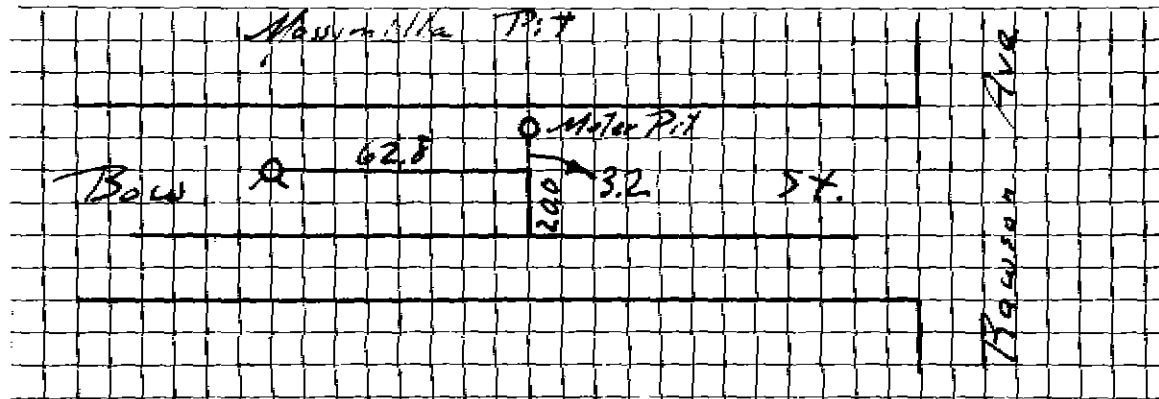

Connection made in Street.

Work completed19

Remarks:

Name Carmine Massimilla

Service No. ⁵⁹ 866

Address 108 Bow Street

Location 108 Bow Street

Kind of Pipe

Size

Size of Main

~~Renewal~~ ~~Service~~

Conn 12/3/47

Location

Date	Material	Amount	Total	Date	Amount
Jul. 15, '47	Labor	1 05	1 05	July 7 47	15 00
	10% Overhead		11	Dec. 31 47	1 93
	21' - 1" Copper Tubing @.38		7 98		13 07
	1 - 1" C x 1" I.W.H. S & W		3 18	Jul. 14, '47	16 47
	Trucking 1 hr. @.75		75	15 "	17 52
			13 07	23' - 1" Copper Tubing @.38	8 74
				1 - 1" C Corp-cock	3 96
				1 - 1" C x 1" C Curb-cock	4 80
				1 - Box & Rod	4 26
				Patching 18 x 3	18 00
				2 - 1" Straight Tail Pieces	1 00
				Compressor 1 hr. @ 1.75	1 75
	Labor			Trucking 1 hr. @.75	75
					77 25

Deposited
Refunded
Non-Charge

TOWN OF LEXINGTON - BOARD OF PUBLIC WORKS
WATER DIVISION


The undersigned applies for a supply of water at No. St. and hereby agrees to comply with the rules and regulations as now, or at any future time, established by the Board of Selectmen.

Am't of Estimate \$..... Owner

Am't Paid \$..... Address

Builder

Sketch of Service Here

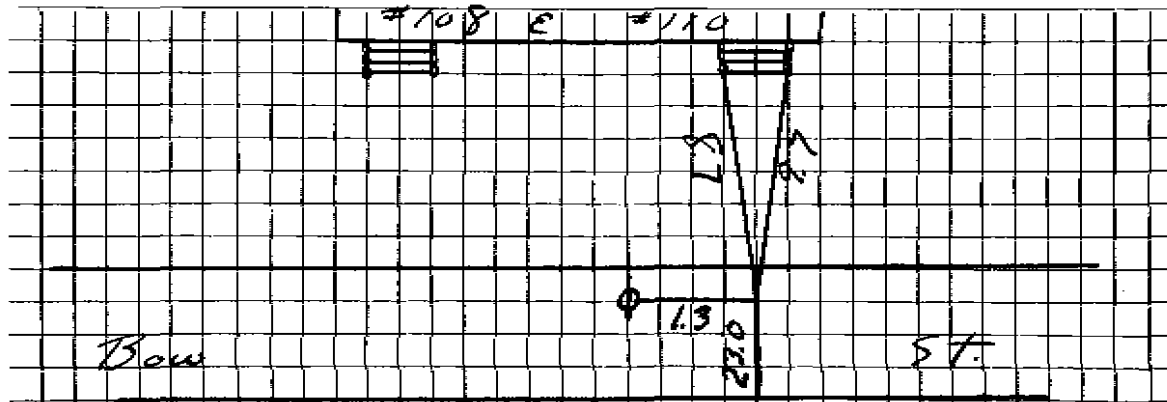

Connection made in Street. Work completed19

Remarks: