

WATER SERVICE RECORD

Name *Carlo Coppola*

Service No. *45*

Address *109 Bow Street*

Location

~~Renewal~~ ~~New Service~~ *WO# 1549*

FEB 10 1975


Date	Material	Amount	Total	Date	Amount	
12-12-'73	Labor	\$40.29		<i>11-38-74</i>	<i>Deposit</i>	<i>125 30</i>
	10% O.H.	4.30	\$44.32	<i>5-11-75</i>	<i>Retund</i>	<i>15 95</i>
					NON CHARGE	<i>109 08</i>
	31' 3/4" Copper Tubing @1.05	32.55		8/20/54	Labor	38 02
	1 3/4 Wheel handle	13.21			10' 3/4" copper tubing @ .35	3 50
	2 Hrs. TRucking@3.00	6.00			1 3/4" C. corp cock	4 33
	2 Hrs. Town Shovel @6.50	13.00			1 3/4" C. curb cock	4 67
					1 box and rod	3 90
					2 hrs. Littlefield shoves @ 7.50	15 00
					1 hr. trucking	75
		\$109.08				xxx
May 8, 1944	Labor	1 60	8 1 60	<i>May 10 Reported</i>		<i>70 17</i>
	10% Overhead		16			<i>15 00</i>
	25' 1" C.L. pipe @ .25		6 25			
	1 3/4" L.L. Elbow		30			
	Trucking 1 hr. @ .75		75			
			9 51			

DATE _____

TOWN OF LEXINGTON — BOARD OF PUBLIC WORKS

WATER DIVISION

Sketch of Service Here

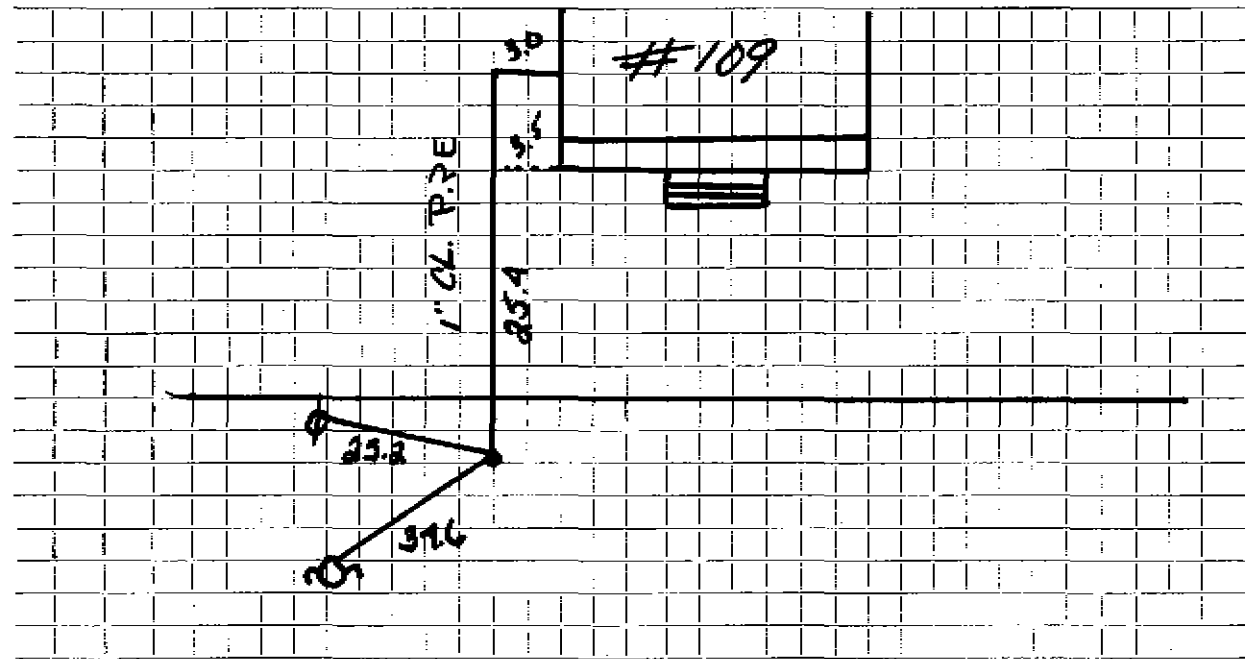

Connection made in Street. Work completed

Remarks:
.....
.....