




DATE 8/20/19

TOWN OF LEXINGTON — BOARD OF PUBLIC WORKS

WATER DIVISION

Sketch of Service Here

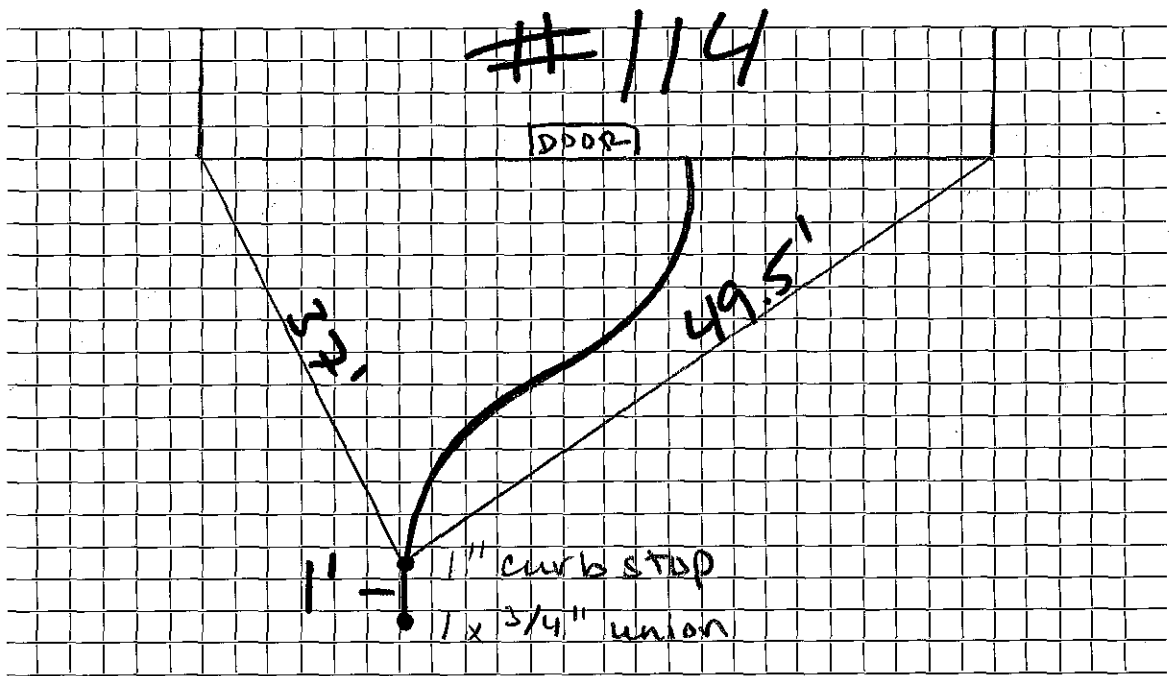

Connection made in Bow Street. Work completed .....

Remarks: .....

.....

.....