


DATE 12/5/96

TOWN OF LEXINGTON — BOARD OF PUBLIC WORKS

WATER DIVISION

Sketch of Service Here

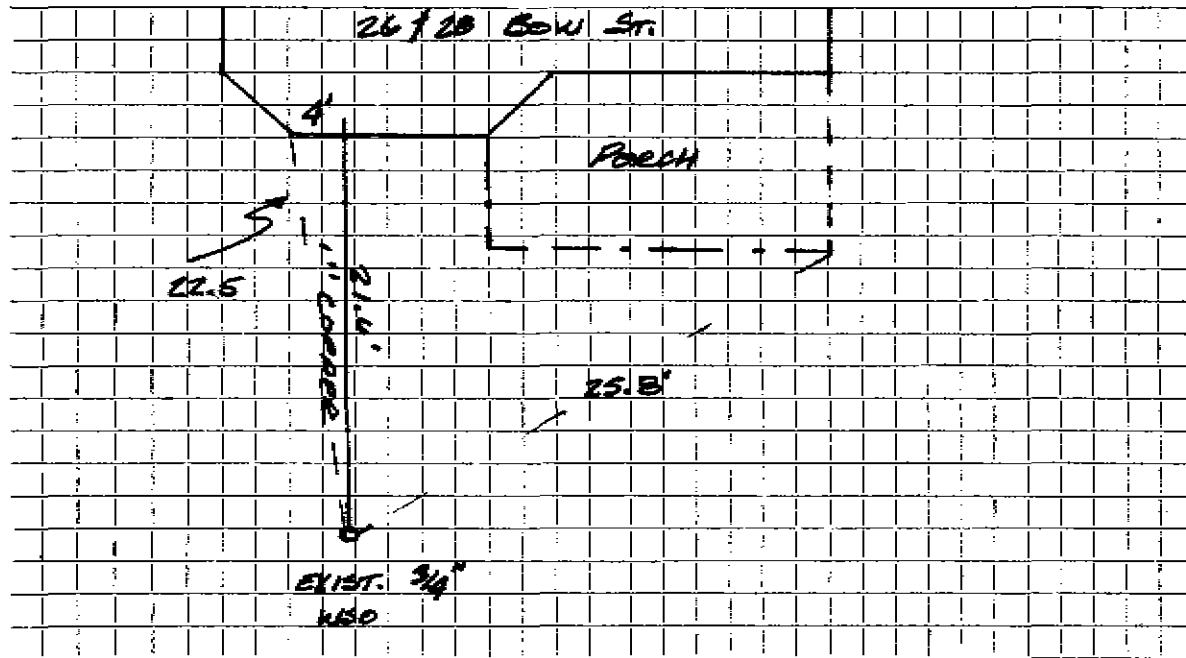

Connection made in BOW Street. Work completed ARLEX OIL COOP.

Remarks:

F.B.# 1996-5 Ag. 5

J.M.