

Name Jerry Cataldo

Service No. 56 349

Address ~~\_\_\_\_\_~~ Bow Street

Location *Curb service opp. House #32*

Kind of Pipe

Size

Size of Main

~~Repair~~ ~~Renewal~~ — New Service

Location

Date	Material	Amount	Total	Date	Amount
	1 1" Curb Cock	2 25			
	1 1 1/2" L.L.El1	45			
	2 1 1/4" Br. Sp. Nip. @.35	70			
	2 1 1/4" x 1" Red. Coup. @.75	1 50			
	2 1" L.L.El1s @.35	70			
	1 Box and Rod	2 50			
	Trucking	75	\$8 85		
6/10/29	4 Hrs. Labor @.55	2 20			
	2 " " @.60	1 20	3 40		
	15% Overhead		51		
	<b>Labor</b>		12 76		

*Nov. 26 1929 - Cash*

*12 76*

Hadley Press, Inc., Washington

DATE \_\_\_\_\_

# TOWN OF LEXINGTON—BOARD OF PUBLIC WORKS WATER DIVISION

The undersigned applies for a supply of water at No. \_\_\_\_\_ St. and hereby agrees to comply with the rules and regulations as now, or at any future time, established by the Board of Selectmen.

Am't. of Estimate \$ \_\_\_\_\_


Owner \_\_\_\_\_

Am't. Paid \$ \_\_\_\_\_

Address \_\_\_\_\_

Builder \_\_\_\_\_

Sketch of Service Here

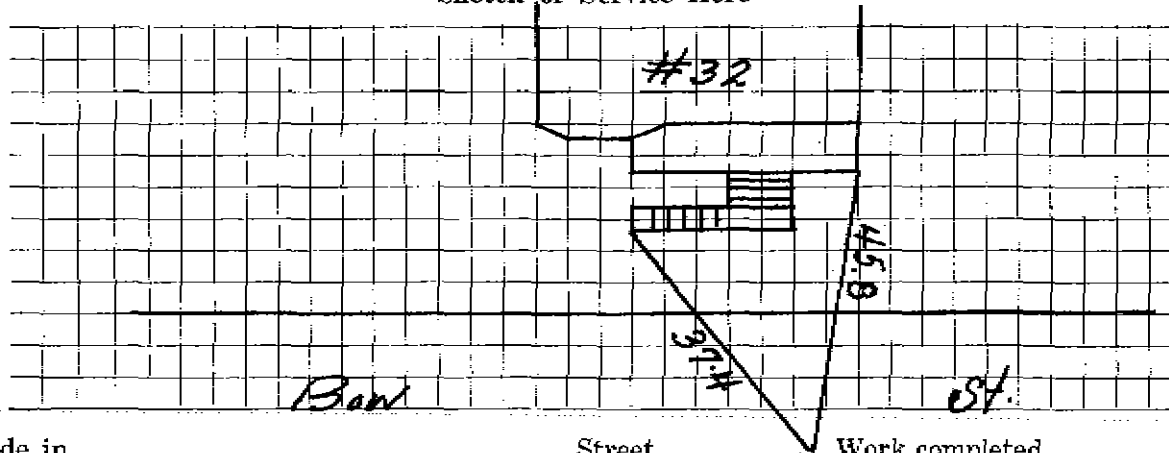

Connection made in \_\_\_\_\_ Street. Work completed \_\_\_\_\_ 19

Remarks: 3-21-73 Dug 20' Along Main 10' on either side could find no Corporation  
J MW