


DATE 12/14/18

TOWN OF LEXINGTON — BOARD OF PUBLIC WORKS
WATER DIVISION

Sketch of Service Here

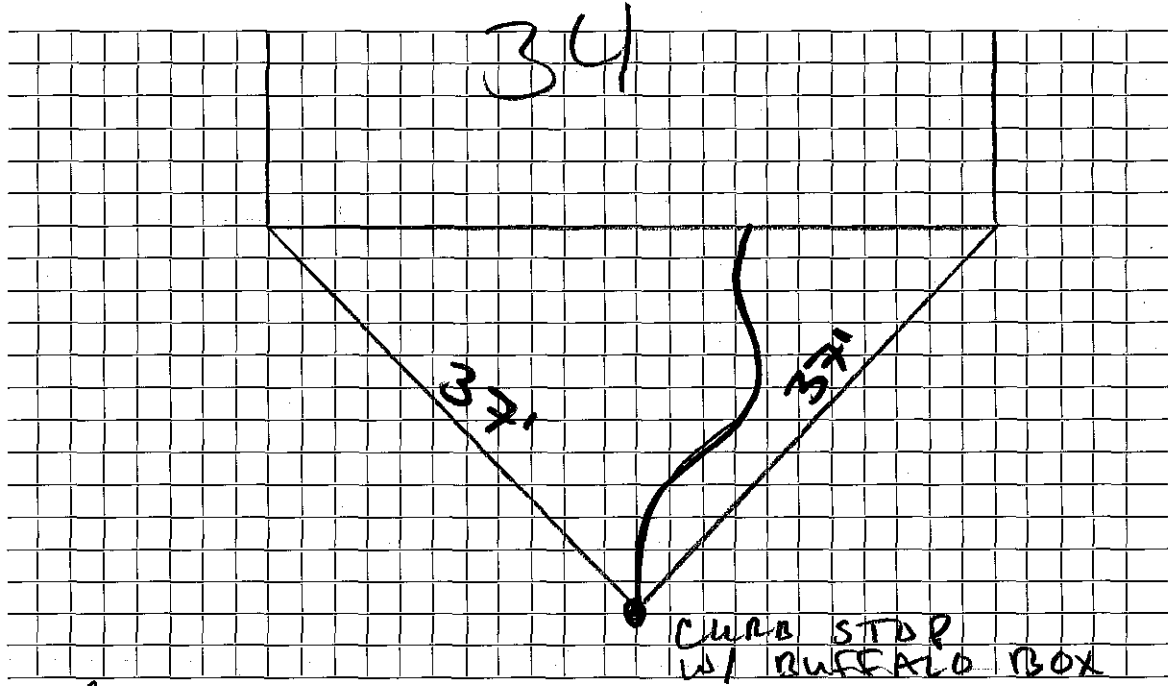

Connection made in Bow Street. Work completed

Remarks: Significant angle coming down towards street