

about 10' back
Renewal

DATE October 27, 1925

TOWN OF LEXINGTON—BOARD OF PUBLIC WORKS
WATER DIVISION

The undersigned applies for a supply of water at No. 38 Bow St. and hereby agrees to comply with the rules and regulations as now, or at any future time, established by the Board of Selectmen.

Am't. of Estimate \$ _____

Owner

Joseph H. Higgins

Am't. Paid \$ 15⁰⁰ 10-27-25


Address

102 Milton St

Builder _____

Arlington Mass

Sketch of Service Here

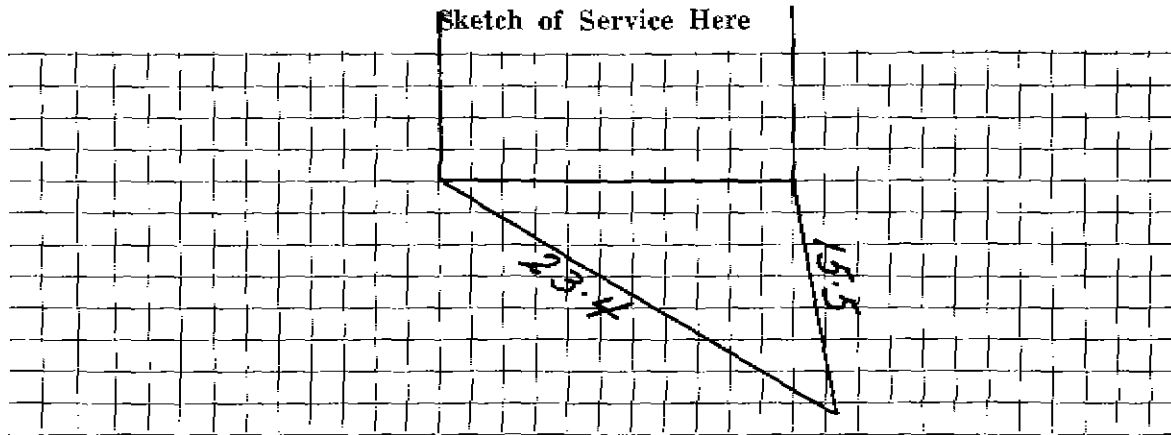

Connection made in _____ Street.

Work completed _____ 19

Remarks: