


DATE DEC 1984

TOWN OF LEXINGTON — BOARD OF PUBLIC WORKS
WATER DIVISION

Sketch of Service Here

LCI #4

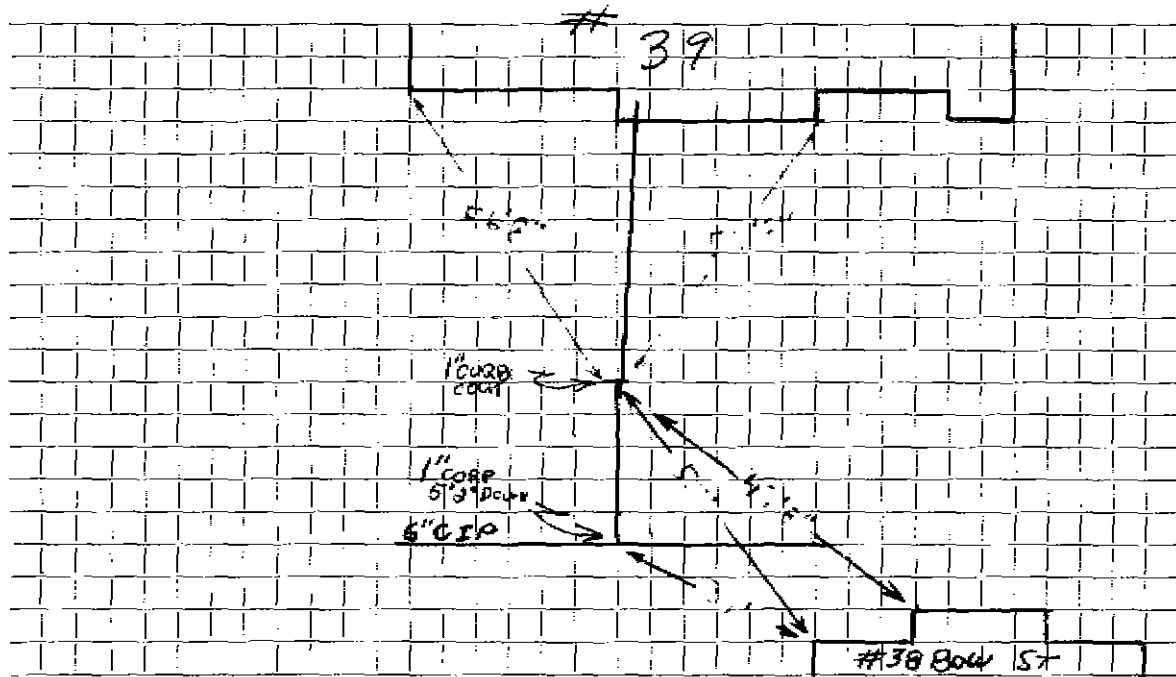

Connection made in Bow St. Street. Work completed DEC 1984

Remarks:

.....

.....