

Name Mrs. James A. Wiggins

Service No. # 352

Address ⁴⁴
~~40~~ Bow St.

Location 44 Bow St

Kind of Pipe

Size

Size of Main

~~Repair—Renewal—New Service~~

Location

Date	Material	Amount	Total	Date	Amount
9/18/33	30' 2" C. Pipe @.14	4 20			
^{9/21-33} _{Conn. 30'}	1 2" C. Bend	70			
	1 S & W	2 75			
	Trucking	75	\$8 40	Sept. 13 1933 - Cash	15 -
				" 19 1933 "	15 -
21	Her. Labor .55	11 55			
3	" " @.60	1 80	13 35	6/21/08	Copper outside checked
	15% Overhead		2 00		
	<u>COST</u>		\$23 40		
<u>CHARGE</u>	30' @ \$1.00	\$30 00	\$30 00		
	Labor				

Hadley Press, Inc., Lexington

~~Pat.~~ (Mrs. Carlson.)

DATE June 14, 1937.

Sec. 1105

TOWN OF LEXINGTON - BOARD OF PUBLIC WORKS

(Zettler & Bow)

WATER DIVISION

3' 9/12/35
10.105-00

The undersigned applies for a supply of water at No. 49 Bow St. and hereby agrees to comply with the rules and regulations as now, or at any future time, established by the Board of Selectmen.

Am't. of Estimate \$ 30-

Owner Mrs. James A. Wiggins


Am't. Paid \$ 30-

Address 40 Bow St.

Builder _____

Lexington

Sketch of Service Here

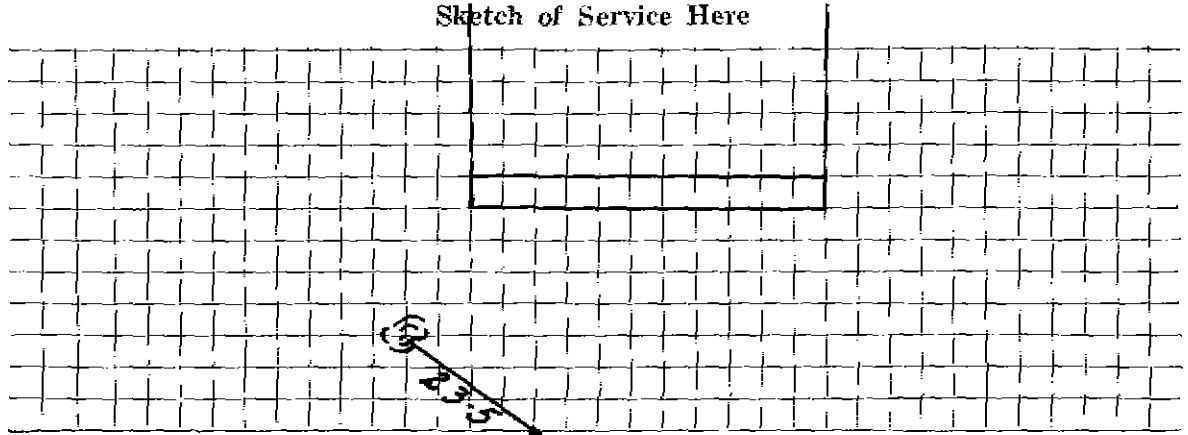

Connection made in _____ Street.

Work completed _____ 19

Remarks: