

**WATER SERVICE RECORD**

Name      Moore Homes Inc.

**Service No.**

Address 45 Bow Street


**Location**

**Repair—Renewal—New Service** Catalog #3944

DATE DEC 18, 1984

TOWN OF LEXINGTON — BOARD OF PUBLIC WORKS  
WATER DIVISION

Sketch of Service Here

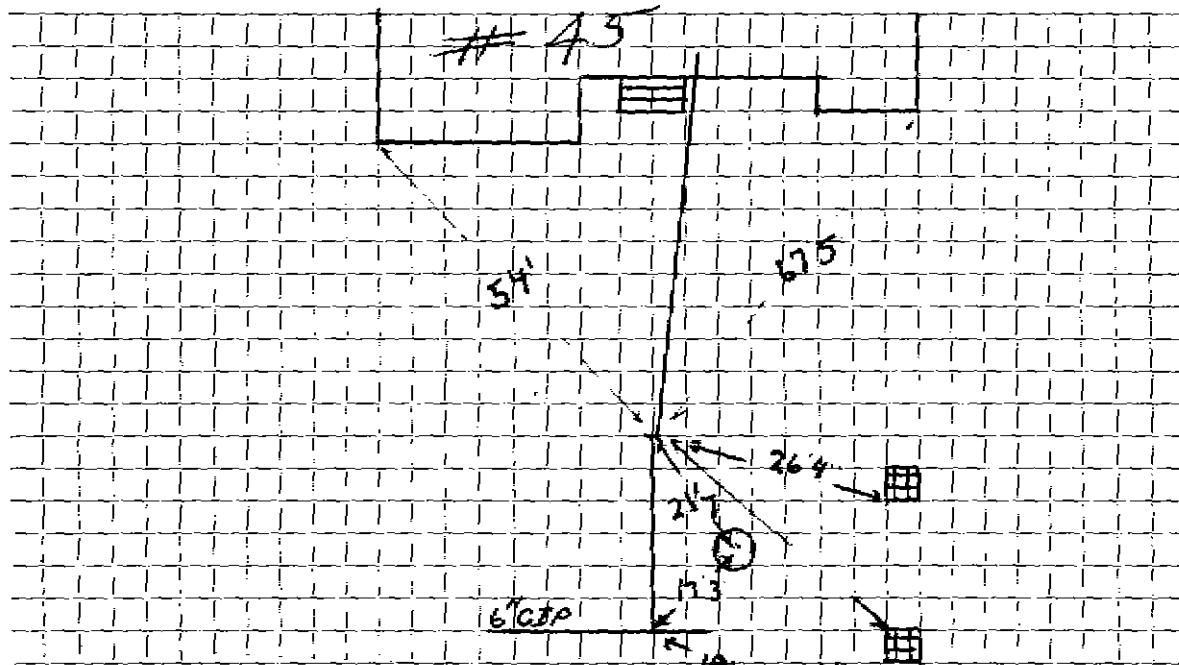

Connection made in Bow St. Street.

Work completed DEC. 1984.

Remarks: .....