

WATER SERVICE RECORD

Name John Reynolds

Service No.

41

Address 50 Bow St.

Location

Repair—Renewal—New Service W. O. #5903


FEB 13 1978

Date	Material	Amount	Total	Date	Amount
11/15/77	Labor	24 13		11-15-77	80 00
	10% O. H.	2 41	26 54	5-17-77	584
	13 3/4 Copper @ .83		10 79		85 84
	1 3/4 Curb		15 07		
	1 3/4 Corp		10 53		
	1 Box & Rod		13 41		
	1 Hr. Trucking		3 00		
	1 Hr. Backhoe		6 50		
12/16/77	34' 3/4' COPPER		85.84		

DATE _____

TOWN OF LEXINGTON — BOARD OF PUBLIC WORKS
WATER DIVISION

Sketch of Service Here

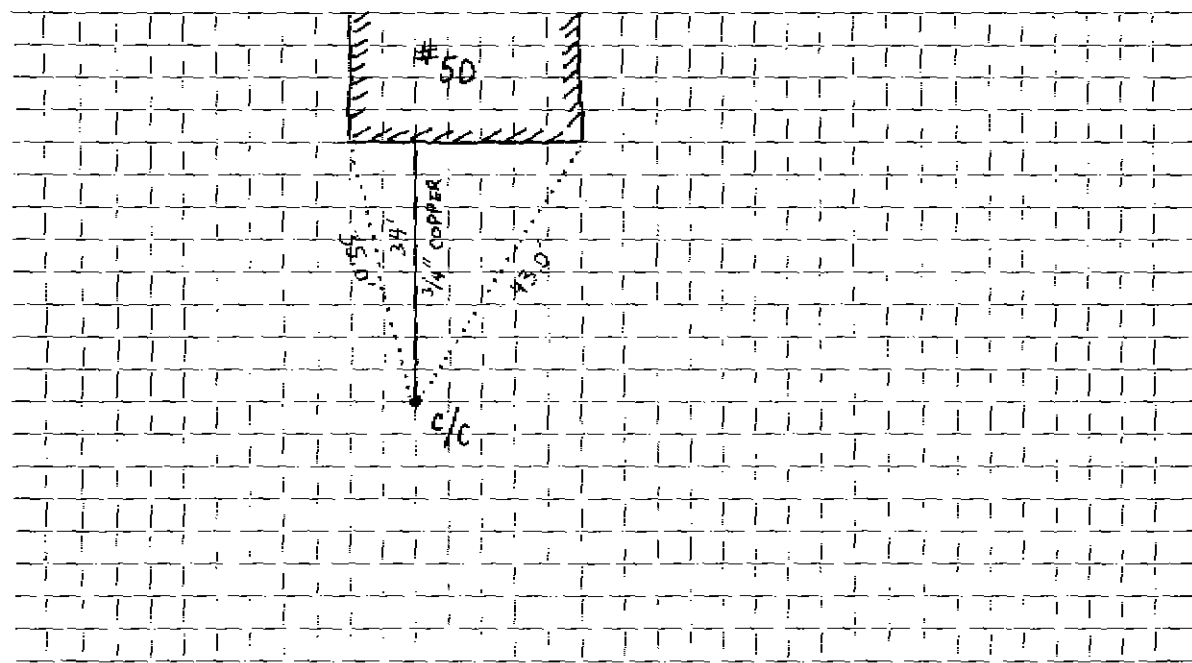

Connection made in Street. Work completed

Remarks:
.....
.....