

WATER SERVICE RECORD

Name Jerry Cataldo

Service No. 290

Address 55 Bow Street

Location

~~Repaired~~ - New Service

Comm. 12-3-56

Date	Material	Amount	Total	Date	Amount
10/8/56	Labor	1 90		9-19-56	Deposit \$50 00
	10% overhead	20	2 10	12-3-56	Refund 13 09
	60' - 3/4" Copper tubing @ .4850	29 10			NON CHARGE 36 91
	1 - 3/4" Cx 1/2 I.W.H. Stop & Waste	4 96			Labor 8 20
	1 hr. trucking		75		24' - 3/4" Copper tubing @ .4850 11 64
			36 91		1 - 3/4" C. Corp Cock 4 64
					1 - 3/4" C. Curb Cock 5 94
					1 Box & Rod 4 62
					1 - 1/2 Straight tailpiece 50
					1 - 1/2 Offset tailpiece 50
					1 hr. Littlefield Shovel @ 8.50 8 50
					<u>44 54</u>


3-28-62 WSL 12-34

DATE _____

TOWN OF LEXINGTON — BOARD OF PUBLIC WORKS

WATER DIVISION

Sketch of Service Here

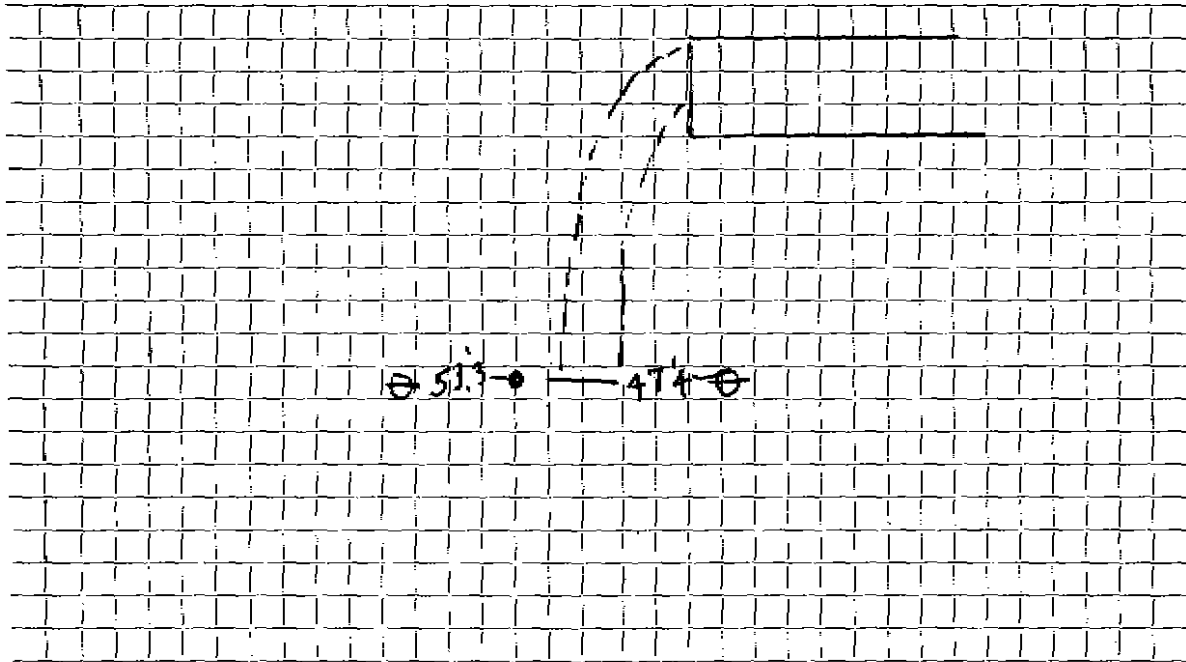

Connection made in Street. Work completed

Remarks:

.....

.....