

WATER SERVICE RECORD

Name Ralph Cataldo

Service No. 29

Address 57 Bow Street

Location

Repair - ~~Renewal~~ - New Service W. O. # 9800

JUL 31 1972


Date	Material	Amount	Total	Date	Amount
6/22/72	Labor		17 92	6-15-72	100 00
	10% O.H.		1 79	7-31-72	23 95
25'	1" Copper pipe .99		24 75		27 65
1	1" Corporation		10 66		
1	1" Curb Stop		14 43		
	Box & Rod		7 50		
			77 05		
6/26/72	45' 1" Copper				
<i>* Applied to S/W # 89</i>					

DATE _____

TOWN OF LEXINGTON -- BOARD OF PUBLIC WORKS

WATER DIVISION

Sketch of Service Here

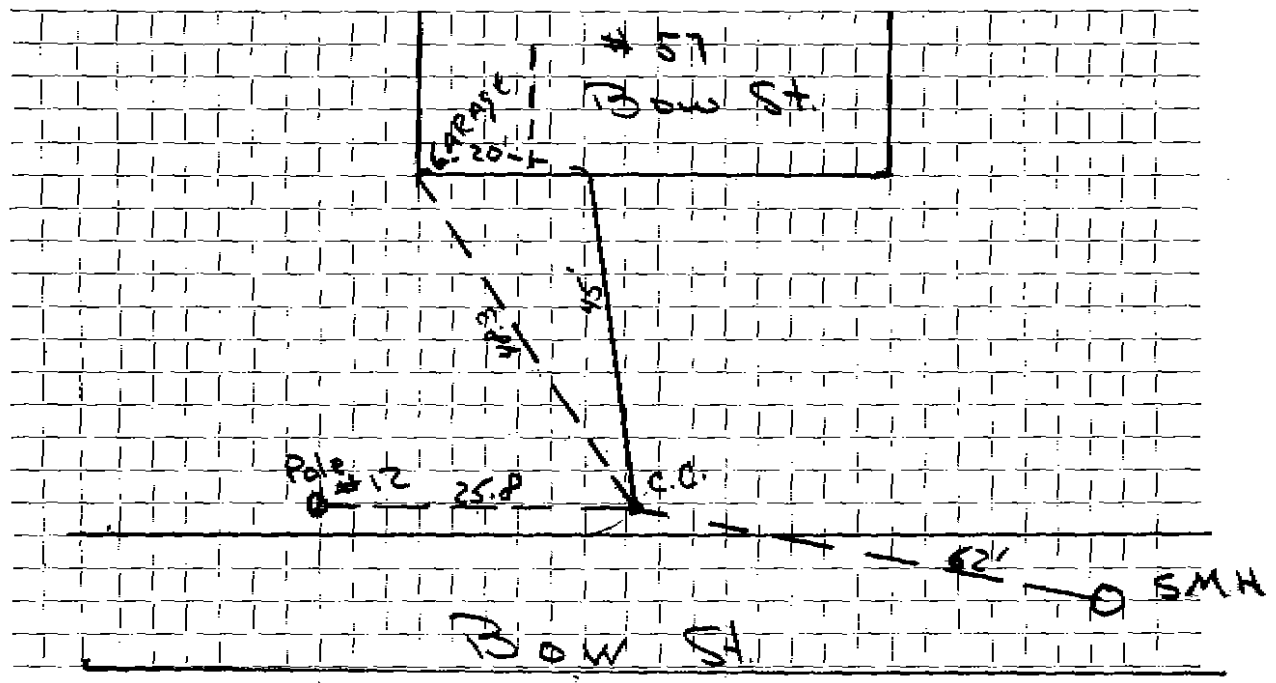

Connection made in Street. Work completed

Remarks:
.....
.....