

WATER SERVICE RECORD

Name Edward Tocio

Service No. 133

Address 58 Bow Street

#7110

Location ~~51 Crescent Hill Ave.~~

Repair—Renewal—New Service

Comm 12-4-61


Date	Material	Amount	Total	Date	Amount	
9/27/61	Labor	2 04		9-24-61	Deposit	50 00
	10% O.H.	20	2 24	12-4-61	Refund	20 59
	50' 3/4" Copper Tubing @ .42		21 00			29 41
	1 3/4" Cx 1/2 IWH Stop & Waste		6 17	9/27/61	Labor	2 32
			29 41		Curb to Main	
					6' 3/4" Copper Tubing @ .42	2 52
					1 3/4" C Corp Cock	4 91
					1 3/4" C Curb Cock	6 28
					1 Box & Rod	4 90
					1 1/2 Straight Tailpiece	50
					1 1/2 Offset Tailpiece	50
						21 93

DATE _____

TOWN OF LEXINGTON — BOARD OF PUBLIC WORKS

WATER DIVISION

Sketch of Service Here

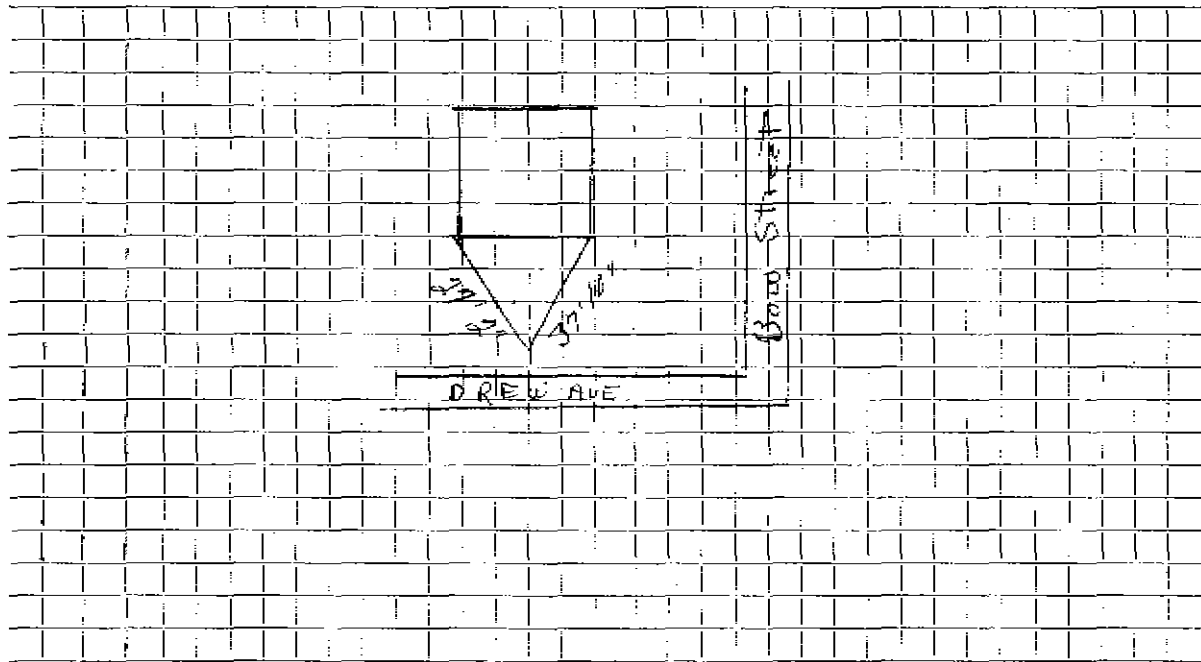

Connection made in Street. Work completed

Remarks:

.....

.....