

WATER SERVICE RECORD

Name Edward Tocio

Service No. 134

Address 62 Bow Street

2168

Location (~~21 Crescent Hill Ave.~~)

Repair—Renewal—New Service


Comm. 12-4-61

| Date | Material | Amount | Total | Date | Amount |
|---------|--------------------------------|--------|-------|---------|----------------------------------|
| 9/27/61 | Labor | 2 32 | | 9-28-61 | Deposit 50 00 |
| | 10% O.H. | 23 | 2 55 | 12-4-61 | Retard 10 23 |
| | 67' 3/4" Copper Tubing @ .42 | | 28 14 | | 39 27 |
| | 1 3/4" Cx 1/2 IWH Stop & Waste | | 6 17 | | |
| | 1 3/4" C 3 part Union | | 2 41 | | |
| | | | 39 27 | | |
| | | | | | <u>Curb to Main</u> |
| | | | | | 6' 3/4" Copper Tubing @ .42 2 52 |
| | | | | | 1 3/4" C Curb Cock 6 28 |
| | | | | | 1 3/4" C Corp Cock 4 91 |
| | | | | | 1 Box & Rod 4 90 |
| | | | | | 1 1/2 Straight Tailpiece 50 |
| | | | | | 1 1/2 Offset Tailpiece 50 |
| | | | | | 21 65 |

DATE _____

TOWN OF LEXINGTON — BOARD OF PUBLIC WORKS
WATER DIVISION

Sketch of Service Here

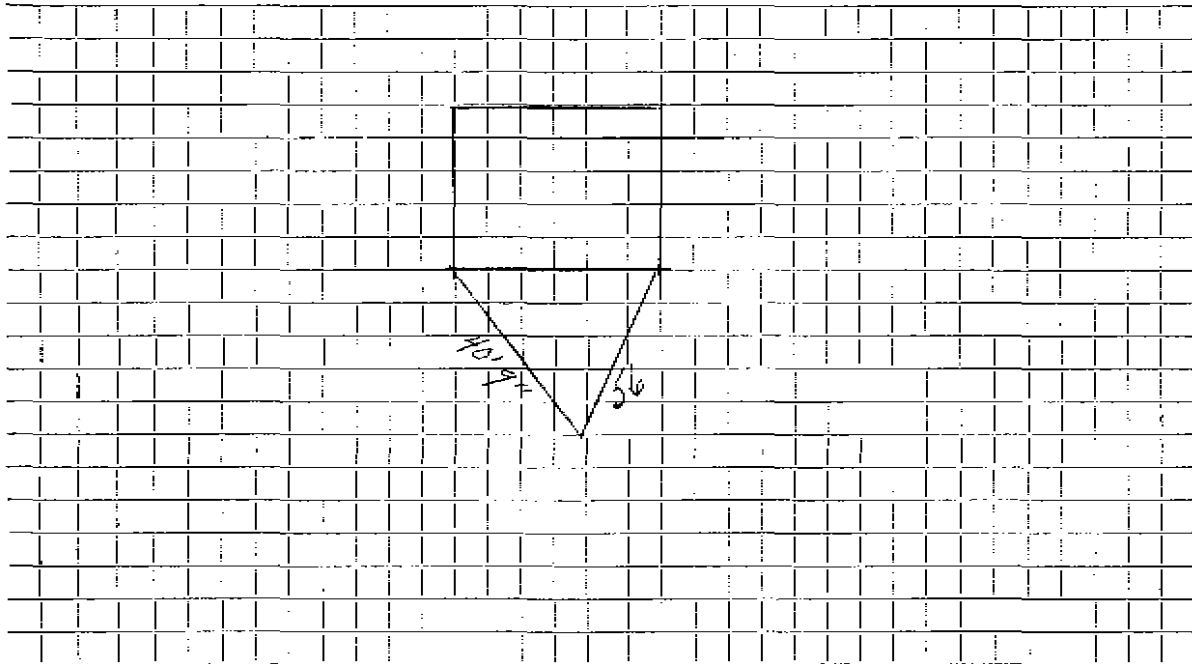

Connection made in Street. Work completed

Remarks:

.....

.....