

**WATER SERVICE RECORD**

Name *Moore Homes*

Service No.

Address *65 Bow Street*

Location


~~Repair~~ ~~Renewal~~ ~~XXXXXXXXXXXX~~ *New Service James McLaughlin #4205*

Date		Material	Amount	Total	Date	Material	Amount
<i>10/4/85</i>	<i>43'</i>	<i>x 1" Copper tubing</i>					
	<i>1</i>	<i>1" R.H. Wheel Valve</i>					
						<i>OUTSIDE</i>	
					<i>10/4/85</i>	<i>35' x 1" Copper tubing</i>	
						<i>1 1" Corp Cock</i>	
						<i>1 1" Curb Cock</i>	
						<i>Box &amp; Rod</i>	

TOWN OF LEXINGTON — BOARD OF PUBLIC WORKS

WATER DIVISION

Sketch of Service Here

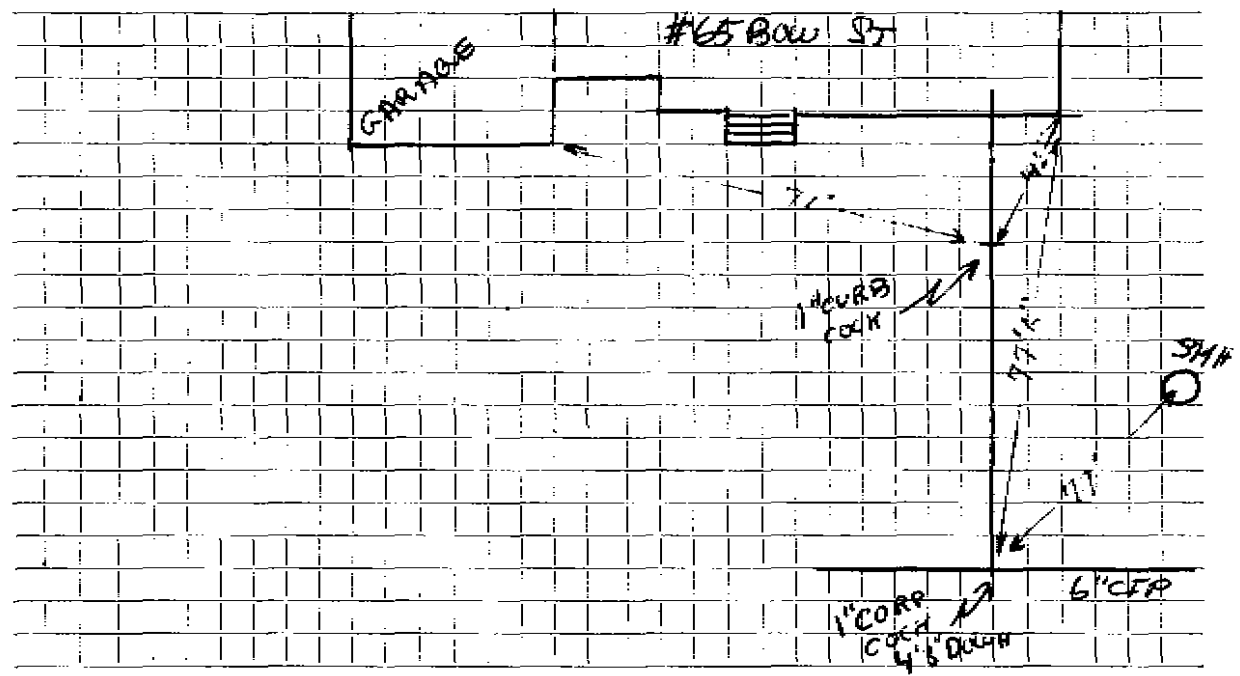

Connection made in Bow St ..... Street. Work completed Oct 7, 1985 .....

Remarks: .....  
.....  
.....