


DATE 13 November 1995

TOWN OF LEXINGTON — BOARD OF PUBLIC WORKS

WATER DIVISION

Sketch of Service Here

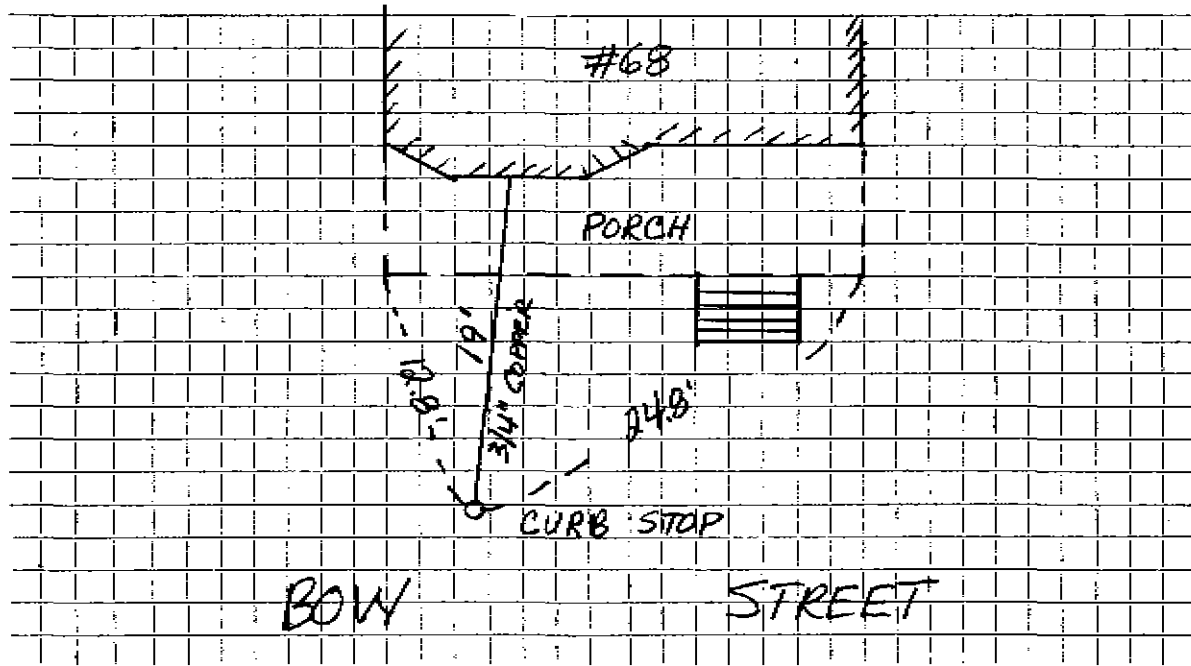

Connection made in BOW STREET Street. Work completed B. MCKEE

Remarks: