




TOWN OF LEXINGTON — BOARD OF PUBLIC WORKS

WATER DIVISION

Sketch of Service Here

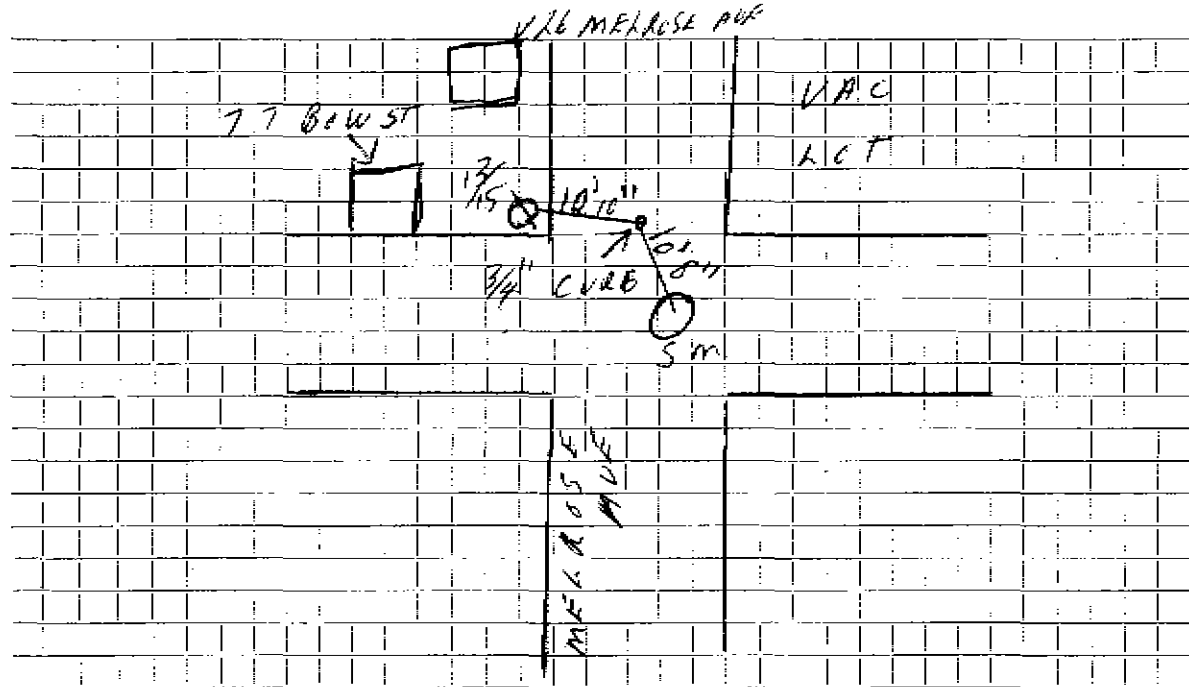

Connection made in ..... Street. Work completed .....

Remarks: 3/4" COPPER FOR VAC LOT  
1" IRON ON INSIDE OF C.F. CURB