

WATER SERVICE RECORD

Name Anthony Augustine

Service No. 17

Address ~~26 Helms Street~~ 71 Bow Street

Location

~~Repair~~ Renewal - New Service W.O. #6420 Valeri #3070


AUG 21 1978

Date	Material	Amount	Total	Date	Amount	
7/11/78	Labor	51.08		6-27-78	Deposit	150.00
	10% O.H.	5.11	56.19		Refund	10.07
26'	1" Copper tubing @.90		23.40			139.93
1	1" Curb		21.88			
1	1" Corporation		17.86			
1	Box & Rod		11.00			
1	Hr. Trucking		3.00			
1	Hr. Backhoe		6.50			
			139.93			
7/12/78	81' 1" Copper					

DATE _____

TOWN OF LEXINGTON — BOARD OF PUBLIC WORKS
WATER DIVISION

Sketch of Service Here

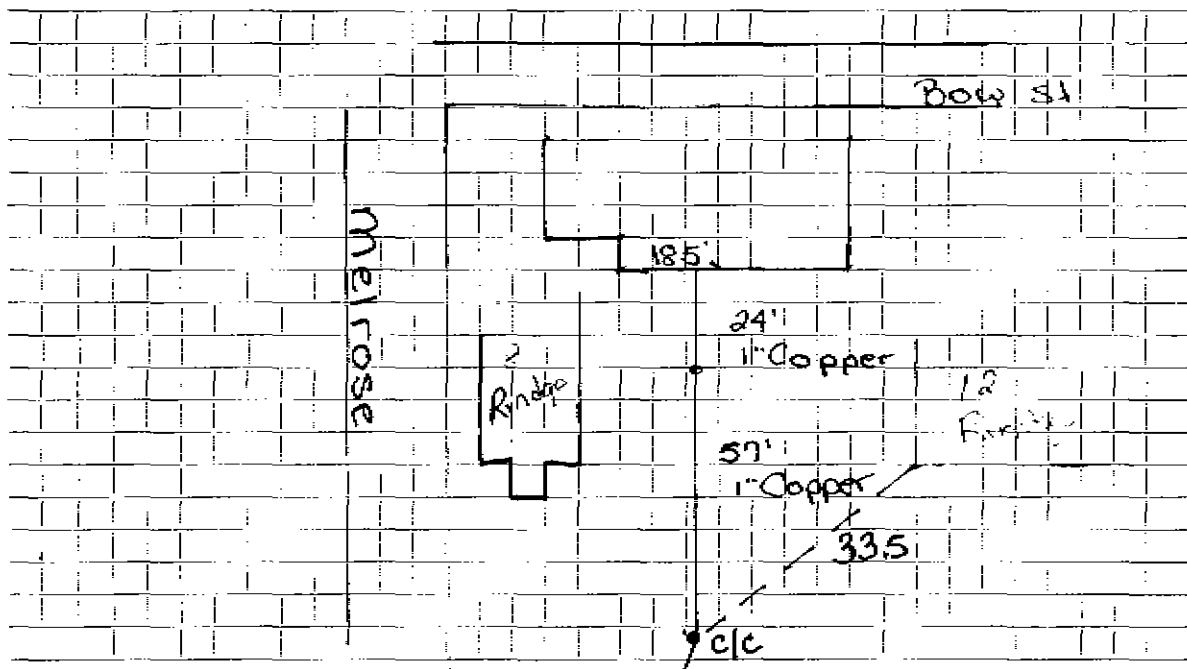

Connection made in Street. Work completed

Remarks: Rindge Ave
.....
.....