

WATER SERVICE RECORD

Name Anthony Moretti

Service No. 296

Address 77 Bow Street

Location Lexington

Repair ~~Renewal~~ - New Service COM. 12-8-52


Date	Material	Amount	Total	Date	Amount
11/14/52	Labor	1 63		10-30-52 Deposited 12-8-52 Paid	20 00 38
	10% Overhead	16	1 79		NON CHARGE 20 68
	56' - 3/4" Copper tubing @ .34		19 04	11/14/52 Labor	1 63
	1 - 3/4" C x 1/2 I.W.H. Stop & waste	4 00		11' - 3/4" Copper tubing @ .34	3 74
	1 hr. trucking		75	1 - 3/4" C. corp-cock	4 33
			25 58	1 - 3/4" C x 3/4" C. curb-cock	4 67
				1 box end rod	3 90
				1 - 1/2 offset tail piece	50
				1 - 3/8 straight tail piece	50
				1 hr. trucking	75
					20 02

DATE \_\_\_\_\_

TOWN OF LEXINGTON — BOARD OF PUBLIC WORKS

**WATER DIVISION**

Sketch of Service Here

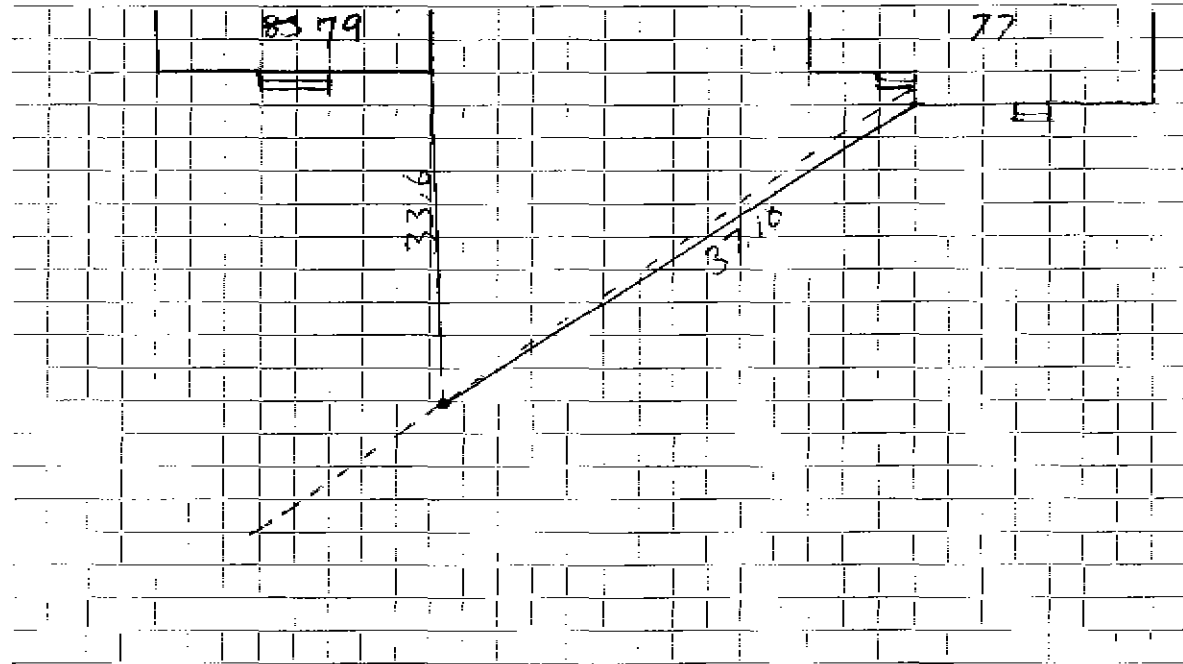

Connection made in ..... Street. Work completed .....

Remarks: *Water & Sewer in same trench*

*Both cut across Property line so sewer could get pitch*