

WATER SERVICE RECORD

Name James D. Mortenson

Service No. 1 (1957)

Address 80 Bow Street

Location

~~Repair~~—Renewal—~~New Service~~


Comm. 3/18/57

Date	Material	Amount	Total	Date	Amount
1-17-57	Labor	75.40		1-14-57	Deposit \$ 150.00
	10% O.H.	7.54	82.94	3-18-57	Refund \$ 37.92
	55' 3/4" Copper tubing @ .4396	24.18			\$ 112.08
	1 3/4" C x 1/2 I.W.H. Stop & Waste	4.96			NON CHARGE
			112.08	1-17-57	
				6 hrs. Town Shovel @ 6.50	39.00
				4 hrs. Compressor @ 2.75	11.00
				3 hrs. Trucking @ .75	2.25
					52.25
					NON CHARGE
				9/30/52	Labor 27.97
					24' 3/4" Copper tubing @ .34 8.16
					1 3/4" C. Adapter 1.95
					1 3/4" C x 3/4" C curb cock 4.67
					5 hrs. Littlefield shovel 35.00
					1 hr. trucking 75
					Patching 20 x 3 20.00
					98.50

DATE _____

TOWN OF LEXINGTON — BOARD OF PUBLIC WORKS
WATER DIVISION

Sketch of Service Here

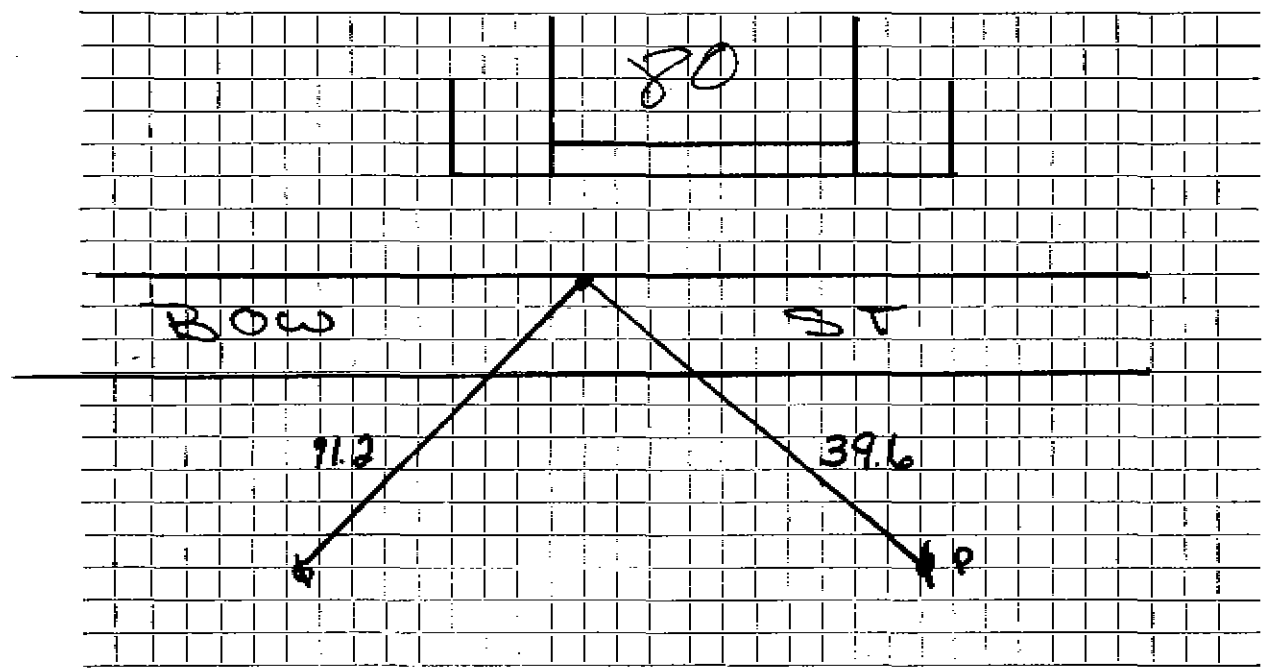

Connection made in Street. Work completed

Remarks:
.....
.....