

WATER SERVICE RECORD

Name Grace Santosuosso

Service No. 206

Address 81 Bow Street

Location

~~Repair~~ ~~Renewal~~ ~~New Service~~


Comm. 12-9-57

Date	Material	Amount	Total	Date	Amount
9-24-57	Labor	29.28		9-19-57	Deposit 50.00
	10 % O.H.	2.93	32.21	12-8-57	Paid 1.55
	19' 3/4" Copper tubing @.375		7.13		\$ 51.55
	1 3/4" C x 3/4" I.W.H.Stop & Waste		.96		NON CHARGE
	1 hr. trucking @.75		.75		Labor 14.64
	1 hr. Town Shovel @ 6.50		6.50		9' 3/4" Copper tubing @.375 3.38
			51.55		1 3/4" Corp Adapter 1.95
					1 3/4" Curb Cock 5.94
					1 3/4" Straight tail piece .50
					8 x 3 Patch 8.00
					1 hr. Town Shovel @ 6.50 6.50
					1 hrs. Tricking @ .75 .75
					41.66
					Bill sent 12-10-57
					\$ 1.55

DATE _____

TOWN OF LEXINGTON — BOARD OF PUBLIC WORKS
WATER DIVISION

Sketch of Service Here

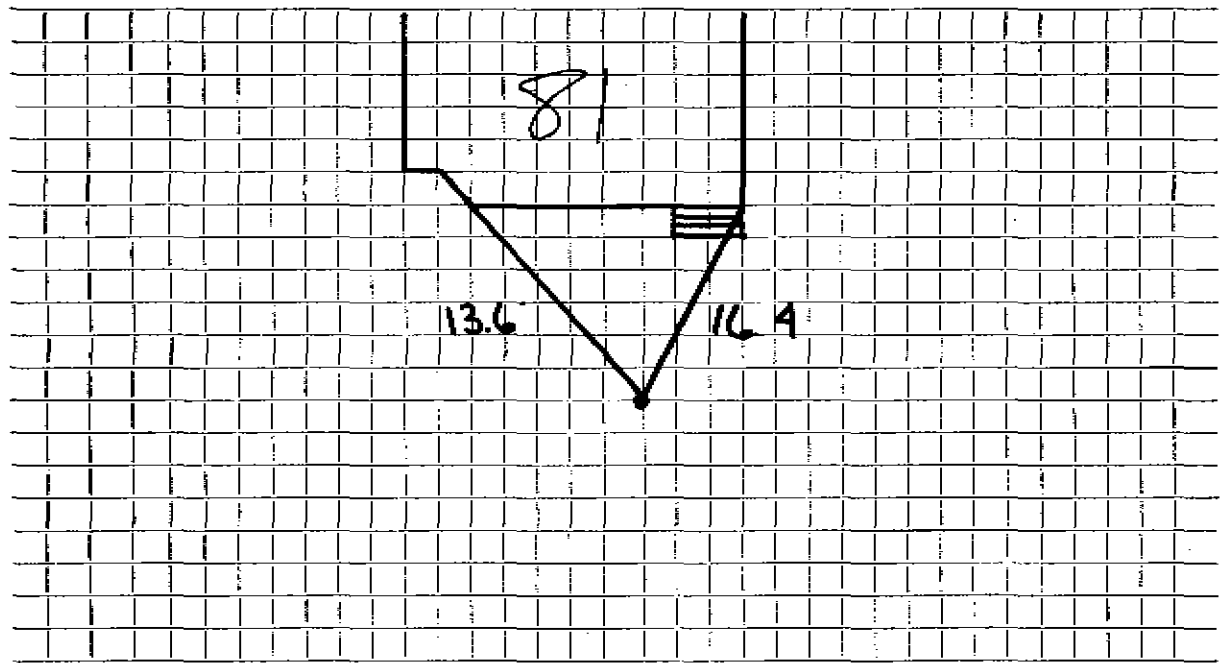

Connection made in Street. Work completed

Remarks:
.....
.....