

Name Peter Scopa

Service No.

Address 34 Bow Street

Lexington, Mass.

Location 34 Bow Street

Kind of Pipe

Size

Size of Main

~~Repair - Renewal~~ - New Service

Com. 8-23-48

Location

Date	Material	Amount	Total	Date	Amount
June 23, '48	Labor	1 15	1 15	June 21, '48	20 00
	100 Overhead		12	April 26, '49	2 06
	27' - 3/4" Copper Tubing	3.255	6 89		27 06
	1 - 3/4" C x 6" I.D. S & W		3 15		
	Trucking 1 hr. @ .75		75	June 23, '48	5 15
	atching 15 x 3		15 00	24' - 3/4" Copper Tubing	6 12
			27 06	1 - 3/4" C Curb-cock	3 00
				1 - 3/4" C x 3/4" C Curb-cock	3 68
				1 - box S Rod	3 55
				1 - 1/2" Straight Tail Piece	30
				1 - 5/8" Offset Tail Piece	30
				Littlefield Shovel 2 1/2 hrs. @ 7.00	17 50
				Trucking 1 hr. @ .75	75
					40 35
	<b>Labor</b>				

*Replaced  
Curb*

For-charge

Hadley Press, Inc., Lexington

# TOWN OF LEXINGTON—BOARD OF PUBLIC WORKS

## WATER DIVISION

The undersigned applies for a supply of water at No. \_\_\_\_\_ St. and hereby agrees to comply with the rules and regulations as now, or at any future time, established by the Board of Selectmen.

Am't. of Estimate \$ \_\_\_\_\_


Owner \_\_\_\_\_

Am't. Paid \$ \_\_\_\_\_

Address \_\_\_\_\_

Builder \_\_\_\_\_

Sketch of Service Here

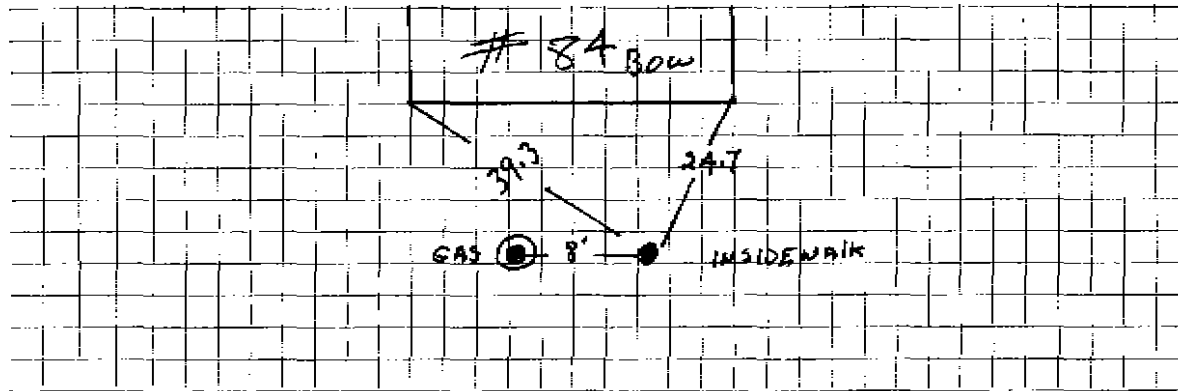

Connection made in \_\_\_\_\_ Street. Work completed \_\_\_\_\_ 19

Remarks:

Name Peter Scopa

Service No. 41

Address 84 Bow Street

Lexington, Mass.

Location 84 Bow Street

Kind of Pipe

Size

Size of Main

~~Repair-Renewal~~ - New Service

Com. 8-23-48

Location

Date	Material	Amount	Total	Date	Amount
June 23, '48	Labor	1 15	1 15	June 21, '48	20 00
	10% Overhead		12	Sept 26 '49	7 00
	27' - 3/4" Copper Tubing @ .255	6 89	6 89	Defeated Card Non-Charge	
	1 - 3/4" C x 1/2" I.W.H. S & W	3 15	3 15		
	Trucking 1 hr. @ .75		75	June 23, '48	5 15
	Patching 15 x 3		15 00	24' - 3/4" Copper Tubing @ .255	6 12
			27 06	1 - 3/4" C Corp-cock	3 00
				1 - 3/4" C x 3/4" C Curb-cock	3 68
				1 - Box & Rod	3 55
				1 - 1/2" Straight Tail Piece	30
				1 - 1/2" Offset Tail Piece	30
				Littlefield Shovel 2 1/2 hrs. @ 7.00	17 50
				Trucking 1 hr. @ .75	75
					40 35
	Labor				

Bill sent 8-22-48

Hadley Press, Inc., Lexington

## TOWN OF LEXINGTON—BOARD OF PUBLIC WORKS WATER DIVISION

The undersigned applies for a supply of water at No. \_\_\_\_\_ St. and hereby agrees to comply with the rules and regulations as now, or at any future time, established by the Board of Selectmen.

Am't. of Estimate \$ \_\_\_\_\_


Owner \_\_\_\_\_

Am't. Paid \$ \_\_\_\_\_

Address \_\_\_\_\_

Builder \_\_\_\_\_

Sketch of Service Here

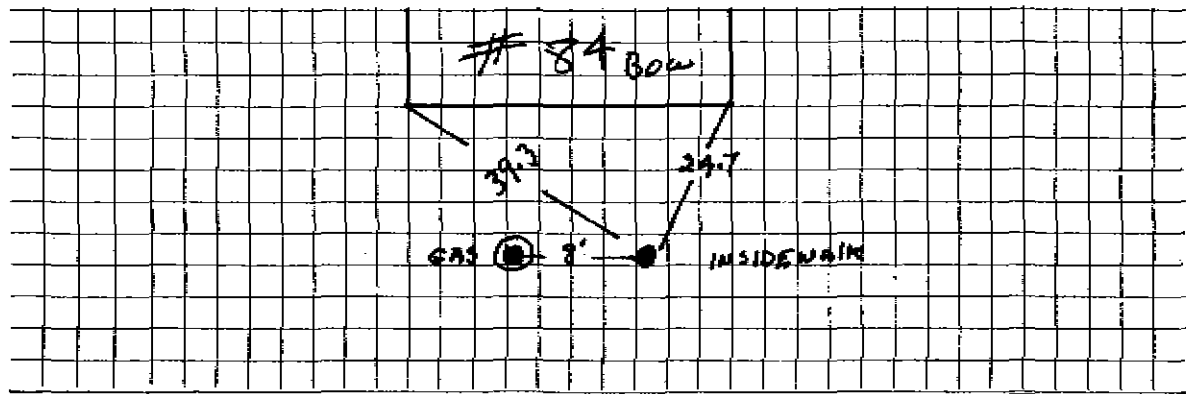

Connection made in \_\_\_\_\_ Street. Work completed \_\_\_\_\_ 19

Remarks: