


Water Service Tie Card
TOWN OF LEXINGTON
 MASSACHUSETTS


89 Bow St

20-74 26 RINDGE AVE

20-87 89 BOW ST

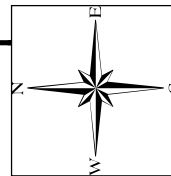

Legend	
	Curb Stop
	Ties_Dimensions
	Water Service Line
	Edge of Pavement
	SEWER MANHOLE
	CATCH BASIN

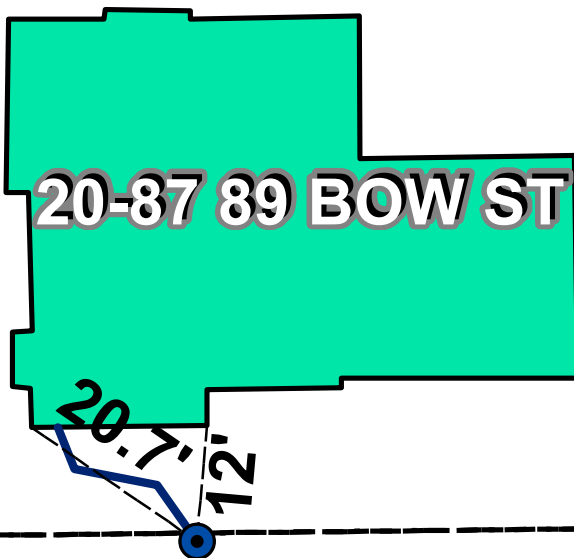

Depth = 5'

BOW STREET



Address	Map and Lot	Permit Number	Contractor Name	Inspector
89 Bow St	20-87	6078	M. Halloran & Sons	dpavlik
Date	Material	Depth of Cover	Amount	
2015	3/4" copper	5 ft	3.5'	
	3/4" to 1" increaser	5 ft	1	
	1" Copper type "k"	5 ft	1.4'	
	1" Curb Valve and Buffalo Box	5 ft	1	
	1" Copper type "k"	5 ft	18'	
Type of work completed				

New 1" water service to house from curb stop. New house on lot old house removed.