

Name Sabina Santosuosso

Service No. 362

Address 91 Bow Street

Location 91 Bow Street

Kind of Pipe

Size

Size of Main

~~Repair~~ Renewal ~~New Service~~

Com. 12-13-49

Location

Date	Material	Amount	Total	Date	Amount
Aug. 30, '49	Labor	1 25	1 25		
	10% Overhead		13	3-17-52	9 98
	19' - 3/4" Copper Tubing @ .24	4 56	4 56		
	1 - 3/4" C x 1/2" I.W.H. S&W	3 29	3 29		
	Trucking 1 hr.		75	Aug. 30, '49	1 25
			9 98	12' - 3/4" Copper Tubing @.24	2 88
				1 - 3/4" C Corp-cock	3 15
				1 - 3/4" C x 3/4" C Curb-cock	3 85
				1 - Box & Rod	3 95
				2 - 1/2" Offset Tail Piece	37
				1 - 1/2" Straight Tail Piece	37
				Trucking 1 hr.	75
					16 57
	Labor				

*No Deposit
Obeled
Non-Charge*

Bill sent 12-2-49

DATE _____

TOWN OF LEXINGTON - BOARD OF PUBLIC WORKS

WATER DIVISION

The undersigned applies for a supply of water at No..... St. and hereby agrees to comply with the rules and regulations as now, or at any future time, established by the Board of Selectmen.

Am't of Estimate \$.....


Owner

Am't Paid \$.....

Address

Builder

Sketch of Service Here

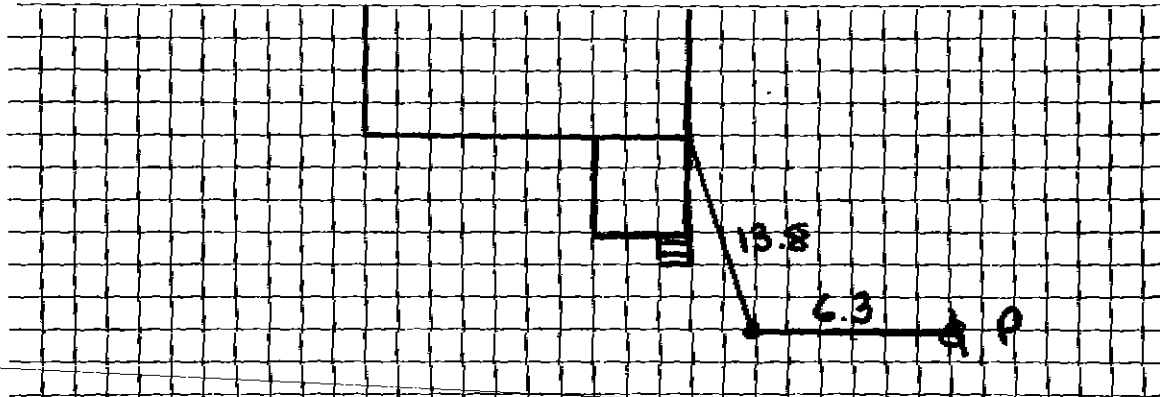

Connection made in Street.

Work completed19

Remarks: