

Name Conchetta Penta
 Address ⁹² Bow Street, Lexington, Mass.

Service No. ~~360~~ 360

2176

Location 92 Bow Street

Kind of Pipe Size Size of Main

~~Repair - Repair~~ - New Service

Location

Date	Material Chargeable	Amount	Total	Date	Amount
May 7, 1942	1 hr.	65		May 3, 1942	27.00
Com 7/6/42	1 "	70	1 35	July 16, 1942	5.75
	10% Overhead		14		21.28
	27' 1" C.L. Pipe @ 25¢		6 75		
	1 1" I. x 3/4" I. Wh. H.S. & W.		2 55	Not chargeable (curb to main)	
	1 1" L. L. Coupling		21	Labor	
	1 1" L. L. Elbow		30	18' 1" C.L. Pipe @ 25¢	4.50
	1 3/4" x 1/2" Bushing		25	5' 3/4" Cop. tub. @ 21¢	1.05
	1 1" Brass close nipple		10	1 3/4" C. Corp. cock	2.25
	1 hr. trucking		75	1 1" I x 1" I. curb cock	3.52
	Trench repairs			1 3/4" C x 1" I. union	.90
			<u>8 88</u>	2 1/2" straight tail pieces	.76
			<u>21 28</u>	1 Box and Rod	1.65
				1 hr. compressor	2.50
				1 hr. trucking	.75
					<u>30.43</u>

DATE Aug 1, 1947

TOWN OF LEXINGTON—BOARD OF PUBLIC WORKS
WATER DIVISION

The undersigned applies for a supply of water at No. 92 Bow St. and hereby agrees to comply with the rules and regulations as now, or at any future time, established by the Board of Selectmen.

Am't. of Estimate \$ 27.50

Owner Conchetta Penta


Am't. Paid \$ _____

Address 96 Bow Street

Builder _____

Lexington, Mass.

Sketch of Service Here

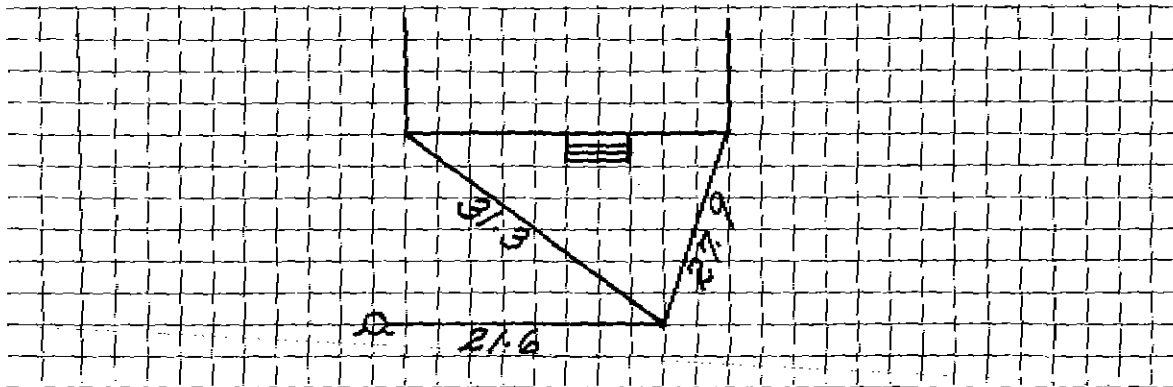

Connection made in _____ Street.

Work completed _____ 19

Remarks: