

WATER SERVICE RECORD

Name Antonio Busa

Service No. 227

Address 94 Bow Street, Lexington

Location Mail: 36 Lowell Street, Lexington

~~Repair - Renewal~~ - New Service

Com. 11-21-55


Date	Material	Amount	Total	Date	Amount
9/26/55	Labor	1 85		7-15-55 Deposited	25 00
	10% Overhead	19	2 04	11-21-55 Refunded	1 41
	30'-3/4" Copper tubing @ .56	16 80		Non Charge	23 59
	1-3/4" Cx 1/2" I.W.H. Stop & waste	4 00			
	1 hr. trucking @ .75		75	9/26/55 Labor	1 85
			23 59	24'-3/4" Copper tubing @ .56	13 44
				1-3/4" C. Corp Cock	4 33
				1-3/4" C. Curb Cock	4 67
				1 Box & Rod	3 90
				1-1/2" straight tail piece	50
				1-1/2" offset tail piece	50
					29 19

DATE _____

TOWN OF LEXINGTON — BOARD OF PUBLIC WORKS

WATER DIVISION

Sketch of Service Here

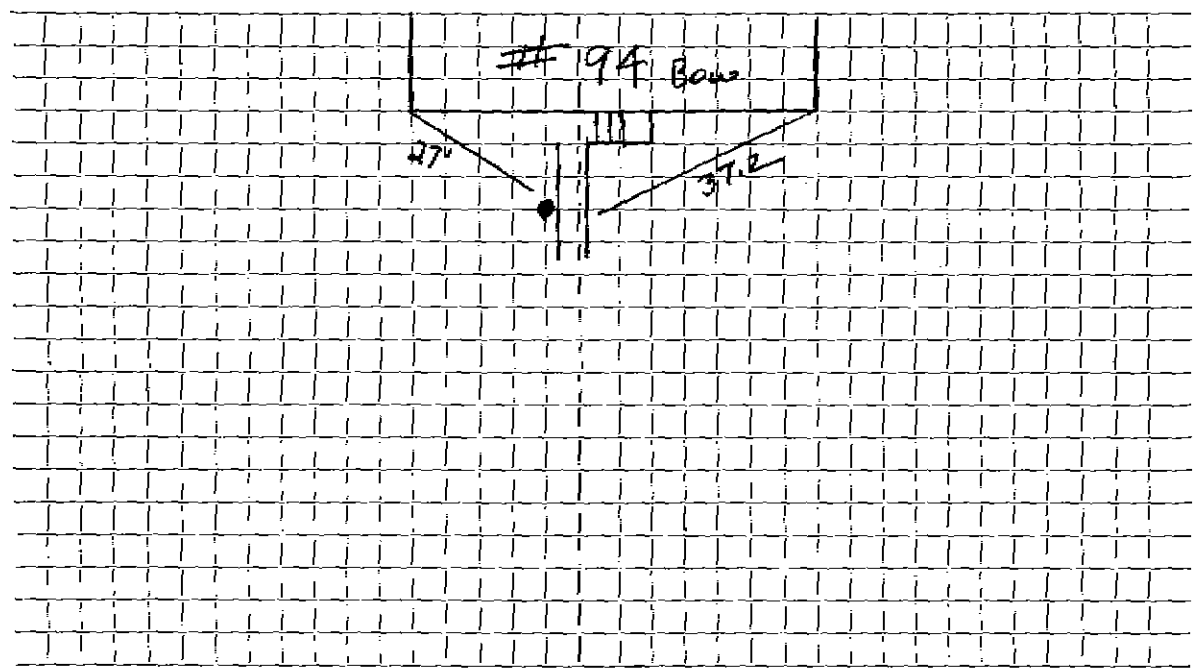

Connection made in Street. Work completed

Remarks:
.....
.....