

Name Peter Penta
 Address 96 Bow Street
 Lexington, Mass.

Service No.

136

Location 96 Bow Street

Kind of Pipe

Size

Size of Main

~~REPAIR~~ Renewal ~~NEW SERVICE~~

Com. 9-26-49

Location

Date	Material	Amount	Total	Date	Amount
Jul. 26, '49	Labor	1 25	1 25	July 15 '49	10 00
	10% Overhead		13		
	17' - 3/4" Copper Tubing @ .24		4 08		
	1 - 3/4" C x 1/2" I.W.H. S&W		3 29	July 26, '49	3 45
	Trucking 1 hr. @ .75		75		5 04
			9 50	21' - 3/4" Copper Tubing @ .24	3 15
				1 - 3/4" C Corp-cock	3 85
				1 - 3/4" C x 3/4" C Curb-cock	3 95
				1 - Box & Rod	74
				2 - 1/2" Straight Tail Pieces	75
				Trucking 1 hr. @ .75	20 93
	Labor				

Deposited

No Charge

TOWN OF LEXINGTON - BOARD OF PUBLIC WORKS

WATER DIVISION

The undersigned applies for a supply of water at No..... St. and hereby agrees to comply with the rules and regulations as now, or at any future time, established by the Board of Selectmen.

Am't of Estimate \$.....


Owner

Am't Paid \$.....

Address

Builder

Sketch of Service Here

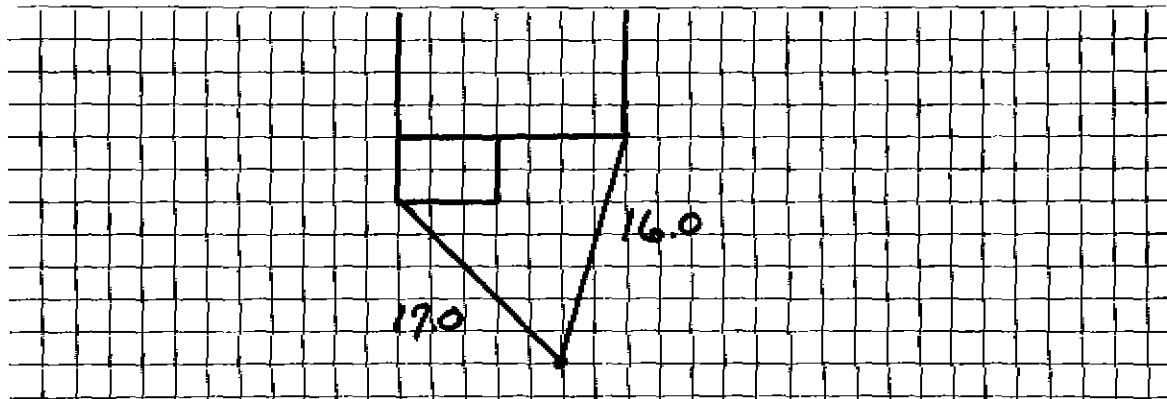

Connection made in Street.

Work completed19

Remarks: