

WATER SERVICE RECORD

Name William C. Savage

Service No. 41

Address 99 Bow Street

Location

Repair—~~General~~ ~~New Service~~ W.O. #5123


MAR 18 1968

Date	Material	Amount	Total	Date	Amount
7/24/67	Labor	22 06		7-19-67	Deposit 75 00
	10% O.H.	2 21	24 27	3-18-67	Refund 18 35
17'	3/4" copper @ .79		13 43		56 75
	3/4" comp. valve		9 30		<u>OUTSIDE</u>
1 1/2	hrs. shovel @ 6.50		9 75	7/24/67	Labor 22.06
			56 75	7/28/67	" 17.69
				7/28/67	" 14.42
					54 17
				17'	3/4" copper @ .79 13 43
					3/4" Gurb 8 37
					3/4" Corp adapter 2 76
					Box & Rod 5 10
				1	Ton hot top 5 80
				1 1/2	hrs. shovel @ 6.50 9 75
				3 1/2	hrs. trucking @ 3.00 10 50
				1	hrs. compressor 5 00
				1/2	hr. loader @ 4.00 2 00
				1/2	hr. roller @ 3.00 1 50
					118 38

DATE _____

TOWN OF LEXINGTON — BOARD OF PUBLIC WORKS
WATER DIVISION

Sketch of Service Here

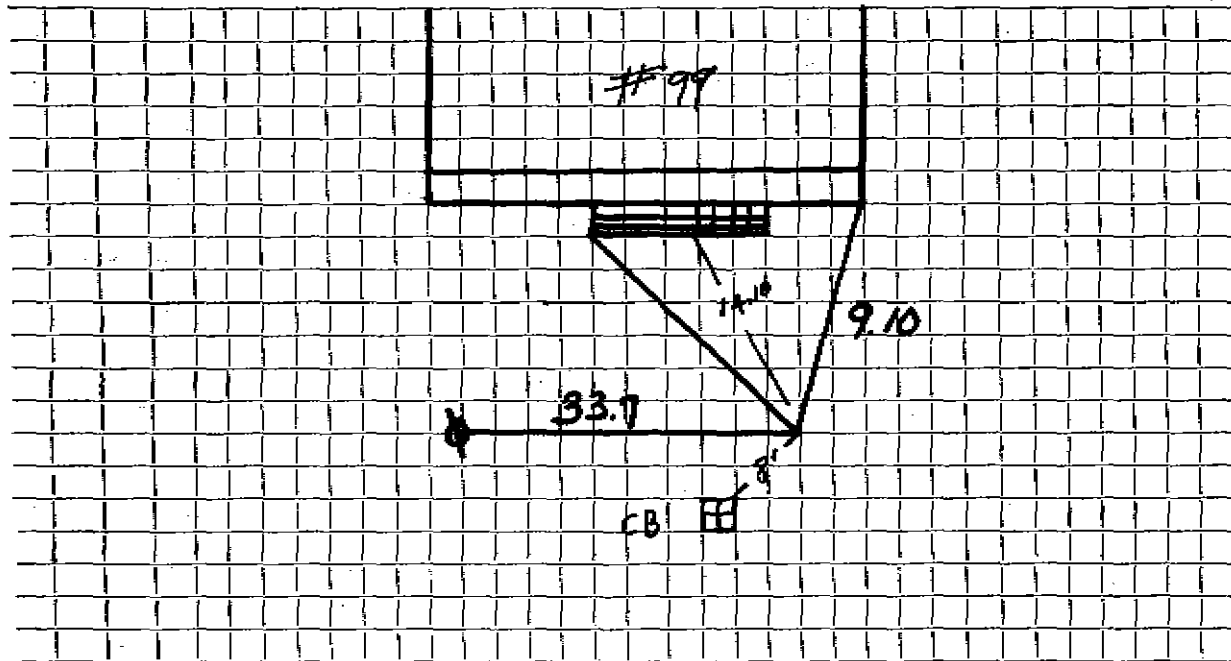

Connection made in _____ Street. Work completed _____

Remarks: _____
