

Name Jerry Cataldo

Service No. ~~38~~ 347

Address Garden Service, near Cliffe Avenue
Bow Street

Bow Street,

Location

Kind of Pipe

Size

Size of Main

Repair—Renewal—New Service

Location

Date
1938

Material

Amount

Total

Date

Amount

June 23

Flat rate building pit and
installing service
Trench repairs

\$20.00

15.00

\$ 35 00

June 28, 1938 Deposited
June 14, 1938 Refunded

41 00

6 00

35 00

Labor

DATE June 21, 190

TOWN OF LEXINGTON—BOARD OF PUBLIC WORKS

WATER DIVISION

The undersigned applies for a supply of water at ~~Nov~~ _____ St. and hereby agrees to comply with the rules and regulations as now, or at any future time, established by the Board of Selectmen.

Am't. of Estimate \$ 41.00 inc. patching


Owner _____

Am't. Paid \$ _____

Address _____

Builder _____

Sketch of Service Here

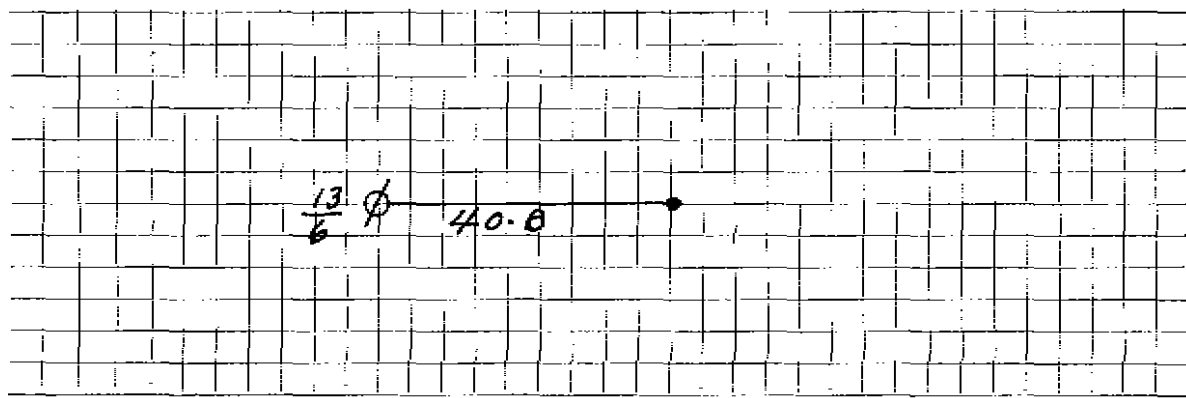

Connection made in _____ Street.

Work completed _____ 19

Remarks: