

WATER SERVICE RECORD

Name

Service No.

Address

10 Bowker ST

Location

LOT 2

Repair—Renewal—New Service

Date	Material	Amount	Total	Date	Material	Amount	Total
1/23/69	38' 3/4 Copper			9/9/09	1" Copper		
	3/4 x 3/4 S.L.W.				1" Copper		
					1" Curb STOP		
					1" x 3/4 Reducer		
					Buffer box		


2005

5'7"

DATE _____

TOWN OF LEXINGTON — BOARD OF PUBLIC WORKS WATER DIVISION

Sketch of Service Here

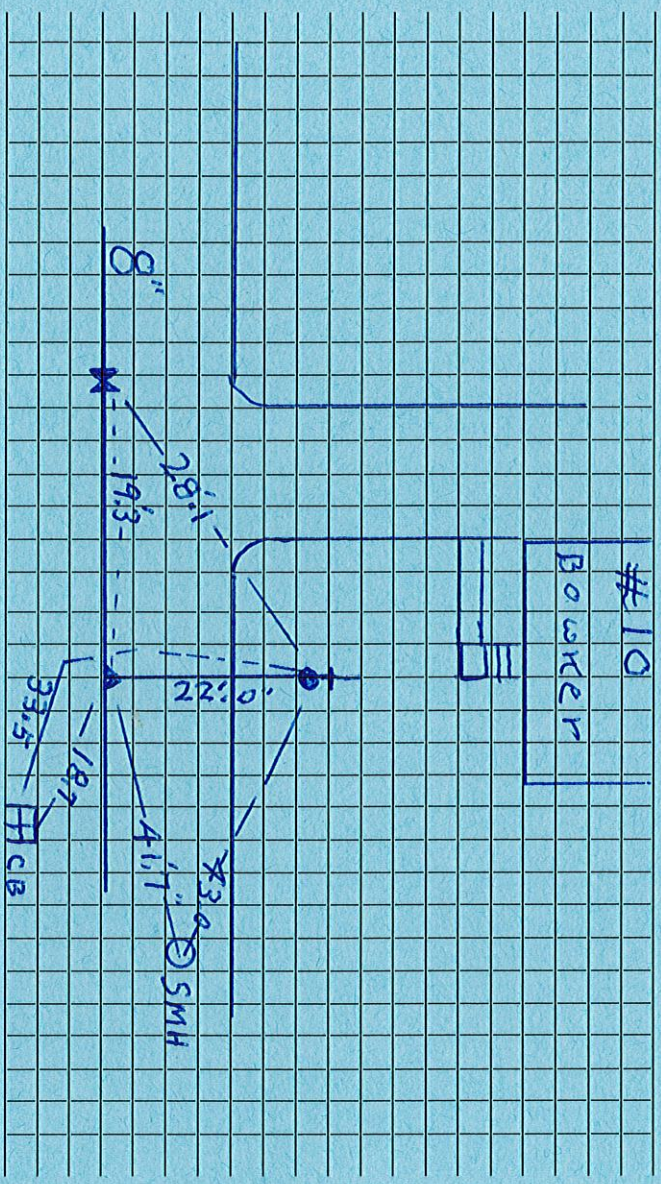

Connection made in

Street

Work completed

9/9/09 PAO