


DATE _____

TOWN OF LEXINGTON — BOARD OF PUBLIC WORKS

WATER DIVISION

Sketch of Service Here

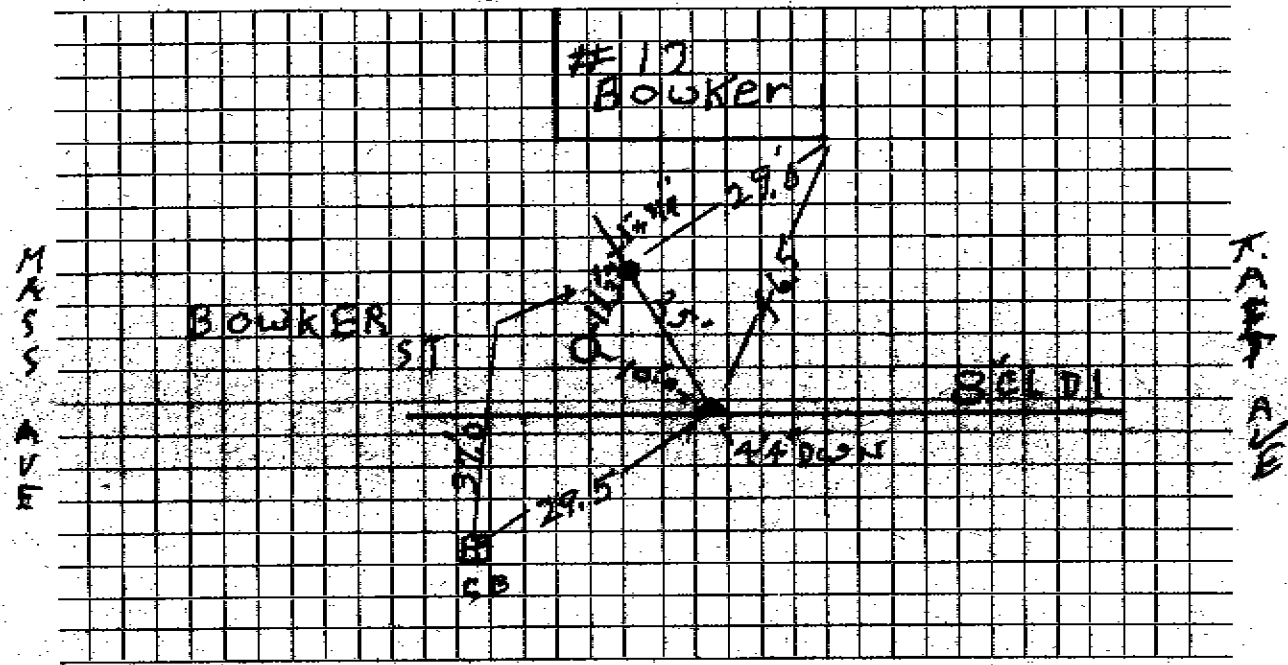

Connection made in Street.

Work completed 9/10/09 P.A.O.-Cov.P.

Remarks: Gas on both sides of water