


DATE _____

TOWN OF LEXINGTON — BOARD OF PUBLIC WORKS

WATER DIVISION

Sketch of Service Here

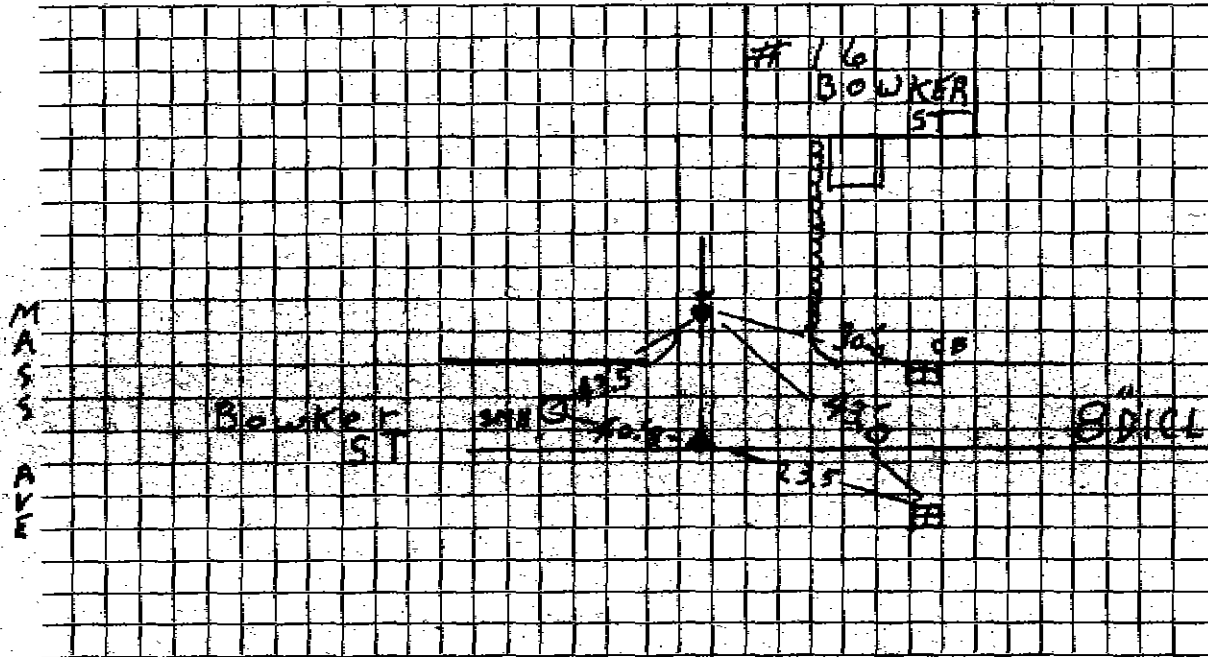

Connection made in Street. Work completed 9/10/09 Paocorp.....

Remarks: Sewer MAIN broken. Repaired w/ F.P.C./concreted IN PLACE.....