




TOWN OF LEXINGTON — BOARD OF PUBLIC WORKS

WATER DIVISION

Sketch of Service Here

21 BOWLER

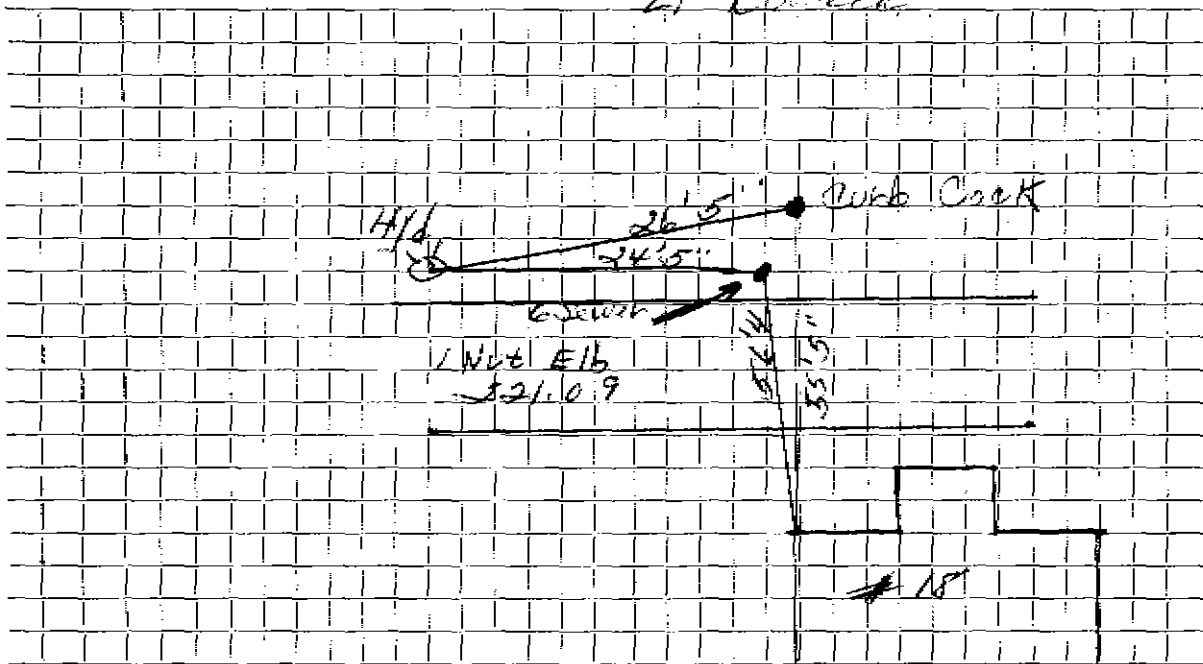

Connection made in ..... Street. Work completed .....

Remarks: .....

.....  
.....