


DATE _____

TOWN OF LEXINGTON — BOARD OF PUBLIC WORKS

WATER DIVISION

Sketch of Service Here

PAO-comp
Fc
Pump
House

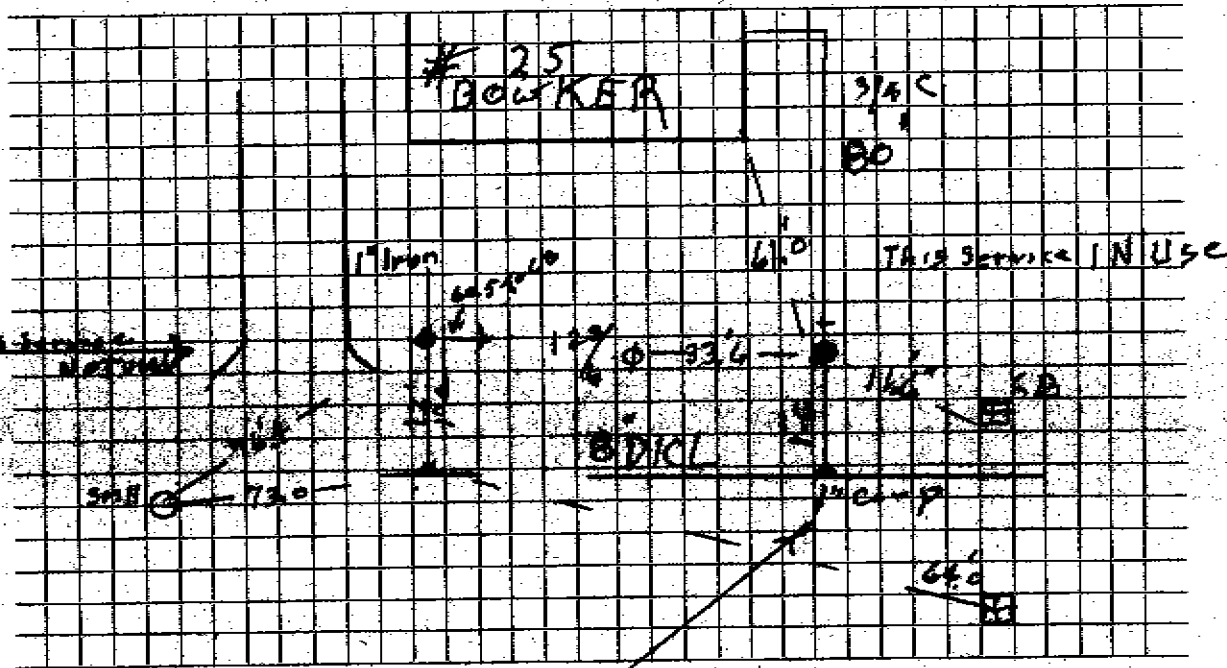

Connection made in _____ Street.

Work completed 9/ / 09

Remarks: This tie is off old Tie Card