




DATE \_\_\_\_\_

TOWN OF LEXINGTON — BOARD OF PUBLIC WORKS

WATER DIVISION

Sketch of Service Here

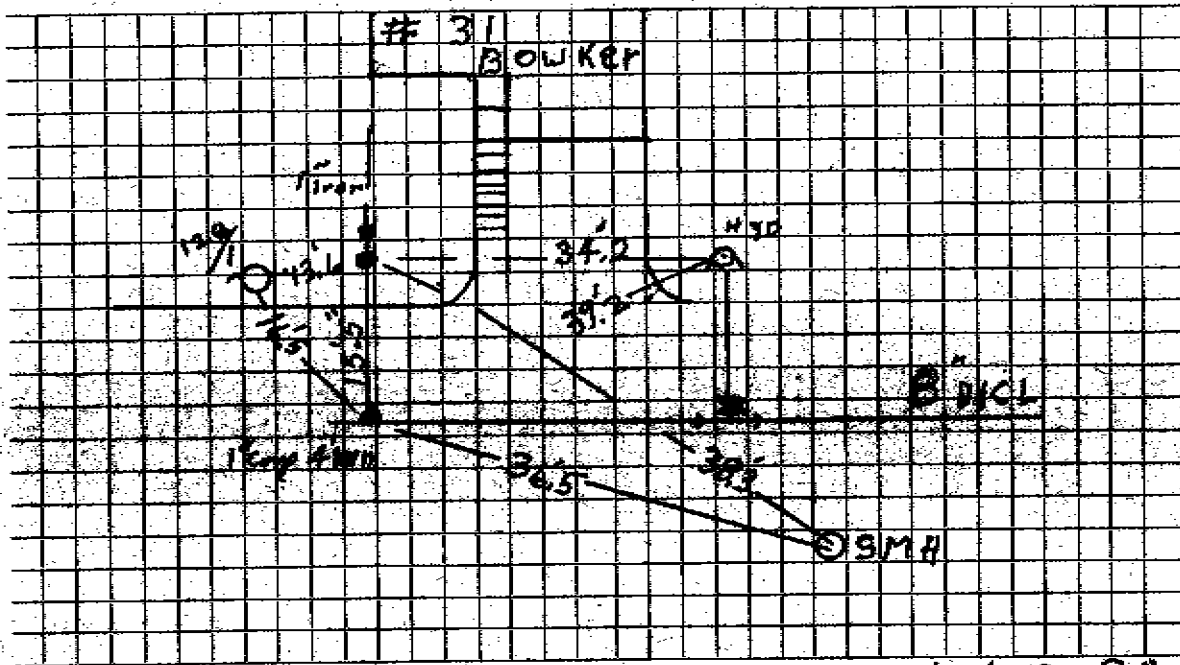

Connection made in ..... Street. Work completed 9/3/09 P.A.O-Corp

Remarks: 1" Iron curb to house V05, Gas on top of Water source