


DATE _____

TOWN OF LEXINGTON — BOARD OF PUBLIC WORKS

WATER DIVISION

Sketch of Service Here

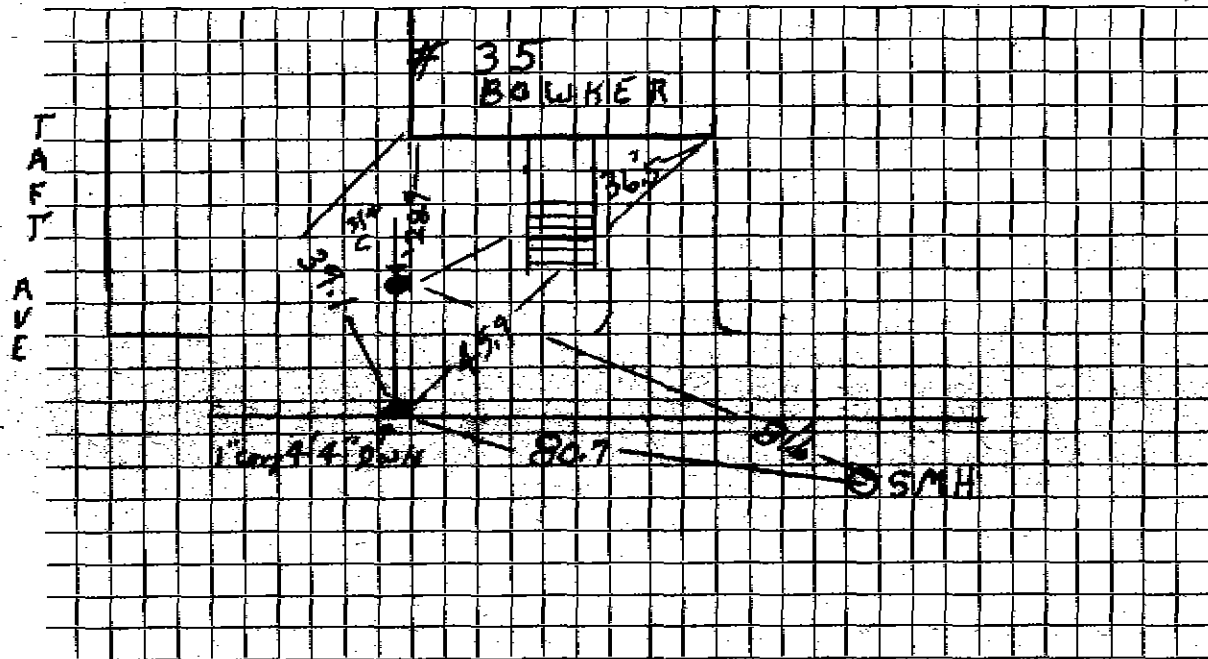

Connection made in Bowker St Street. Work completed 9/2/09 PAO

Remarks:
.....
.....