


DATE _____

TOWN OF LEXINGTON — BOARD OF PUBLIC WORKS

WATER DIVISION

Sketch of Service Here

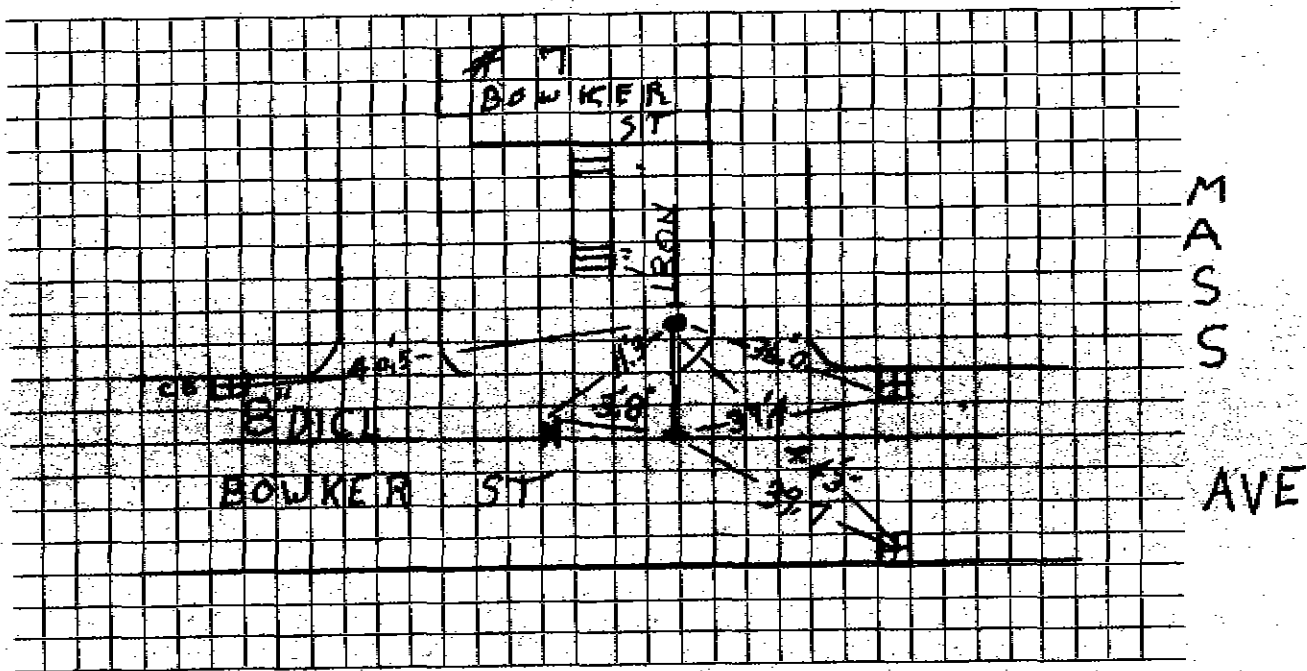

Connection made in _____ Street.

Work completed 9/8/09 PAO Corp.

Remarks: 1" GAL. Pipe to house