

Name John Loder
 Address 15 Bowman Street
 Lexington, Mass.

Service No. 286

Locatic 15 Bowman Street

Kind of Pipe Size Size of Main

~~x Repair & Renewal~~ - New Service

Com. 11-6-50

Location

Date	Material	Amount	Total	Date	Location	Amount
Sept. 13, '50	Labor	5 40	5 40	Sept. 13, '50	Labor	5 40
	10% Overhead		54			54
	33' - 3/4" Copper Tubing @.275	9 08			No Charge	
	1 - 3/4" C x 1/2" I.W.H. S&W		3 76	Sept. 13, '50	Labor	5 40
	Littlefield Shovel 1 hr. @ 7.00	7 00			13' - 3/4" Copper Tubing @.275	3 58
	Trucking 1 hr. @.75		75		1 - 3/4" C Corp-cock	3 60
	Patching 10 x 3		10 00		1 - 3/4" C x 3/4" C Curb-cock	4 40
			36 53		1 - Box & Rod	3 35
					1 - 1/2" Offset Tail Piece	42
					1 - 1/2" Straight Tail Piece	42
					Littlefield Shovel 1 hr. @ 7.00	7 00
					Trucking 1 hr. @.75	75
	Labor					28 92

DATE _____

TOWN OF LEXINGTON—BOARD OF PUBLIC WORKS

WATER DIVISION

The undersigned applies for a supply of water at No. _____ St. and hereby agrees to comply with the rules and regulations as now, or at any future time, established by the Board of Selectmen.

Am't. of Estimate \$ _____


Owner _____

Am't. Paid \$ _____

Address _____

Builder _____

Sketch of Service Here **15**

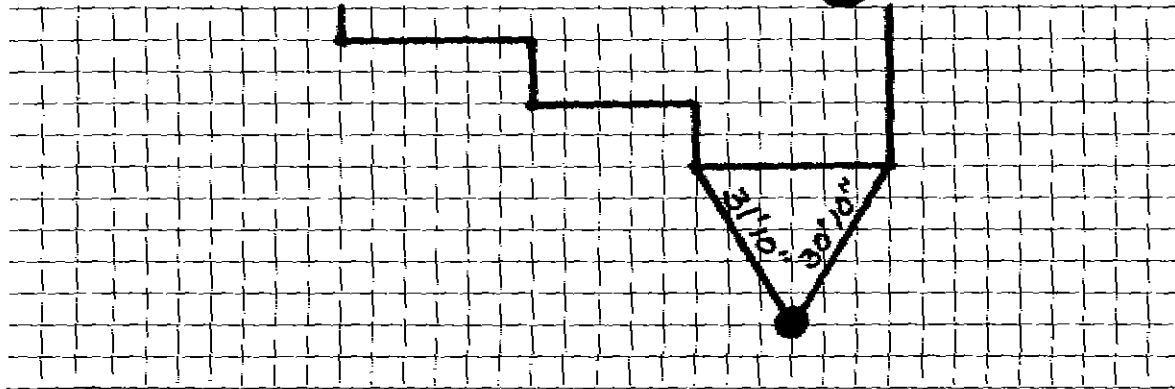

Connection made in _____ Street. Work completed _____ 19

Remarks: