

WATER SERVICE RECORD

#1551

Name Richard Foley

Service No. 181

Address 3 Bowser Road

Location Lot #22 Sta. 7+87 EL. 180.65

~~Repair of Service~~ New Service

WC # 7781

Comm 6-3-63


Date	Material	Amount	Total	Date	Material	Amount
6-22-62	Labor	2.13		12-19-63	Deposit	35.00
	10% O.H.	.21	2.34	1-3-63	Paid by SHC # 228	13.09
	11' 3/4" Copper tubing @.42		4.62			48.09
	1 hr. Trucking @3.00		3.00			
	BILL WHEN CONNECTED		9.96		NON CHARGE	
4-18-63	Labor	4.72		6-22-62	Labor	2.13
	10% O.H.	.47	5.19		26' 3/4" Copper tubing @.42	10.92
	58' 3/4" Copper tubing @.42		24.36		1 3/4" C Curb Cock	6.28
	1 3/4" C x 1/2 I.W.H. Stop & Waste		6.17		1 3/4" C Corp Cock	4.91
	1 3/4" C 3 part union		2.41		1 Box & Rod	4.90
			48.09			29.14
					1 3/8 Straight tailpiece	.50
					1 3/8 Offset tailpiece	.50
						30.14

DATE _____

TOWN OF LEXINGTON — BOARD OF PUBLIC WORKS

WATER DIVISION

Sketch of Service Here

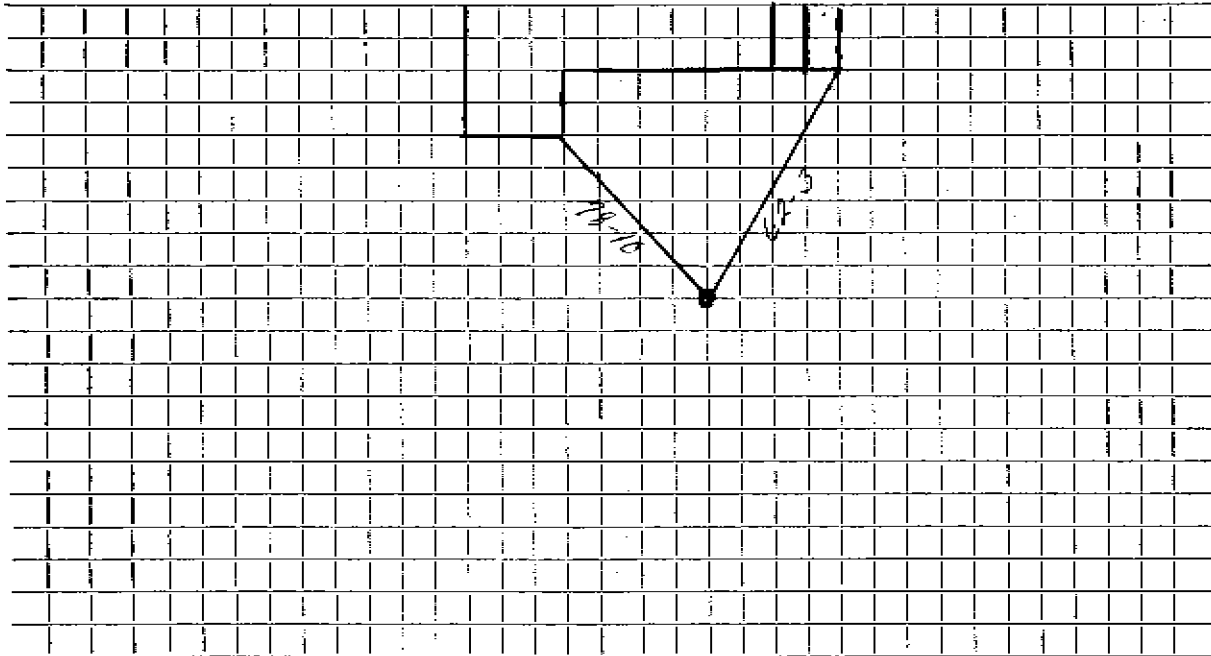

Connection made in Street. Work completed

Remarks:

.....

.....